



KIMPTON PALOMAR SOUTH BEACH 1750 Alton Road
Miami Beach, FL 33139


PB23-0609

Final Submittal 02-25-2024

Plans – Modification to CUP



Scoped of Application: Modification of Planning Board Order No. 2279 to
permit rooftop access.

ALTA/NSPS LAND TITLE SURVEY

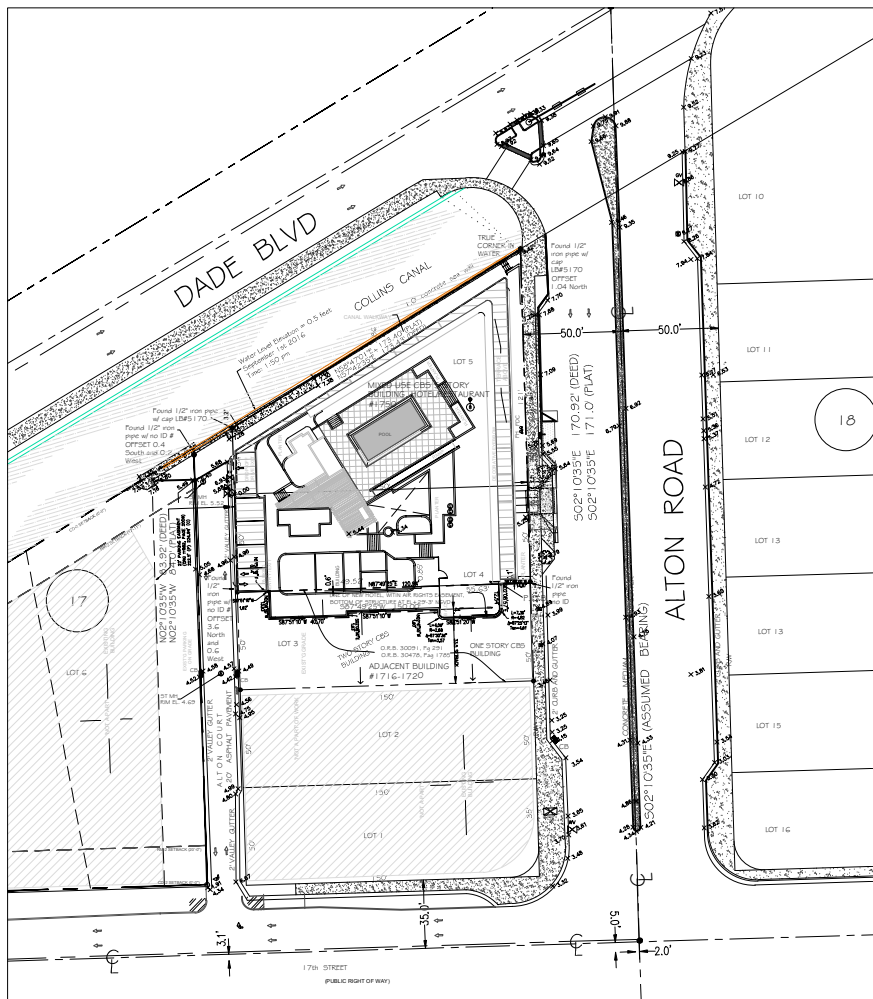

This is to certify that this map or plat and the survey on which it is based were made in accordance with the 2016 Minimum Standard Detail Requirements for ALTIMETER Land Title Surveys, jointly established and adopted by ALTA and NFPS, and includes Items 1, 2, 3, 4, 6(B), 7(B), 8, 13, 16, 17, 18 and 20 of Table A thereof.

The field work was completed on 03/16/2016. Said described property is located within an area having a Zone Designation "AE" by the Secretary of Housing and Urban Development, on Flood Insurance Rate Map No. 12086C0317L, with a date of identification of 09/11/2009, for Community Number 120651, in Miami-Dade County, State of Florida, which is the current Flood Insurance Rate Map for the community in which said property is situated.

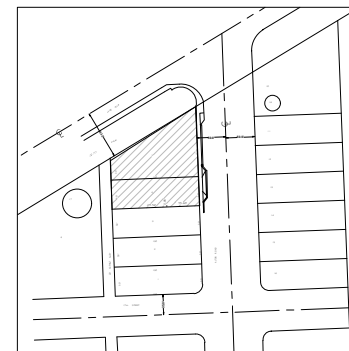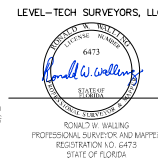

LOCATION SKETCH
PORTION OF SECTION 21, TOWNSHIP 52 SOUTH, RANGE 42 EAST
MIAMI-DADE COUNTY, FLORIDA
NOT TO SCALE

WALLING Date: 2023.11.10
16:23:59 -05'00"

RONALD W WALLING Digitally signed by
RONALD W WALLING
Date: 2023.11.10
16:23:59 -05'00'

LEVEL-TECH SURVEYORS, LLC
 777 N.W. 72ND AVENUE,
 MIAMI, FL 33126
 SUITE 3134
 TEL: 305.261.8493
 FAX: 305.261.8781
 LB # 7134

DRAWINGS ARE THE PROPERTY OF LEVEL-TECH SURVEYORS, LLC, AND MAY NOT BE USED BY CLIENT ON OTHER PROJECTS EXCEPT BY AGREEMENT IN WRITING WITH THE APPROPRIATE CONSENTATION TO LEVEL-TECH SURVEYORS, LLC.

RECORD OF REVISIONS	
DATE	DESCRIPTION
11-07-23	UPDATE ALTA SURVEY

NAME AND TYPE OF PROJECT:		ALTA/NSPS Land Title Survey	
PROJECT LOCATION:		CLIENT ADDRESS:	
1750 Alton Rd, Miami Beach Florida		CLIENT TELEPHONE:	
CLIENT:		SUBS ALTON, LLC	
SCALE:		AS SHOWN	
DATE OF FIELD WORK:		FILE WITH:	
11-01-2023		FILE WITH:	
DRAWN BY:		FILE WITH:	
TR		FILE WITH:	
FIELD BOOK:		FILE WITH:	
AR-23-11-1869		FILE WITH:	
PROJECT NO:		FILE WITH:	
LT 23-11-1869		FILE WITH:	
SHEET:		FILE WITH:	
1		FILE WITH:	
OF		FILE WITH:	
1		FILE WITH:	
SHEET		FILE WITH:	



20 % PARKING REDUCTION DIAGRAM

Scale: N.T.S.

NOTE:
RED LINE DESCRIBES 905'-0"
FROM SITE TO PARKING GARAGE.

UNIT MATRIX				
FLOOR	300 SF	336 SF AND ABOVE	UNIT/FLOOR	NUMBER OF FLOORS
	# OF UNITS	# OF UNITS		
1	0	0	0	5
2	0	0	0	
3	4	28	32	
4	4	28	32	
5	4	28	32	
TOTAL	12	84	96	5
PERCENTAGE	13%	88%	100%	

AREA CALCULATIONS					
LEVEL	F.A.R.		GROSS	CIRCULATION	LEASABLE
	PROPOSED	EXISTING			
1	8,222 SF	5,114 SF	9,999 SF	975 SF	5,425 SF
2	1,772 SF	2,408 SF	13,483 SF	975 SF	0 SF
3	13,133 SF		14,938 SF	2,232 SF	0 SF
4	13,133 SF		14,938 SF	2,229 SF	0 SF
5	13,133 SF		14,938 SF	2,229 SF	0 SF
ROOF TOP	716 SF		14,938 SF	545 SF	0 SF
	57,631 SF		83,234 SF	9,185 SF	5,425 SF
					TOTAL

PARKING REQUIREMENTS (A)			
LEVEL	USE	FLOORS	AMOUNT
LEVEL 1	RETAIL	0	
	RESTAURANT	160	1 prs seven seats / 40 SPACES
LEVEL 3-5	HOTEL	96	48 SPACES
TOTAL			88 SPACES

LOADING REQUIRED		
LEVEL	AMOUNT	
	3	SPACES

PARKING PROVIDED		
LEVEL	AMOUNT	
1	2	8.5 X 21 SPACES
	1	8.5 X 21HC SPACE
2	28	LIFTS (56 SPACE)
	59	TOTAL

LOADING PROVIDED		
LEVEL	AMOUNT	
1	3	SPACES
	3	TOTAL

INDEX		
SHEET	DRAWING NUMBER	DRAWING NAME
1	C 1.00	COVER SHEET
2	A 1.00	INDEX AND DATA SHEET
3	1	BOUNDARY SURVEY
4	A 1.01	AERIAL MAP
5	A 1.02	SITE CONTEXT PHOTOS
6	A 1.03	SITE CONTEXT PHOTOS
7	A 1.04	SITE CONTEXT PHOTOS
8	A 1.05	SITE CONTEXT PHOTOS
9	A 1.06	SITE CONTEXT PHOTOS
10	A 1.07	SITE CONTEXT PHOTOS
11	A 1.08	SITE CONTEXT PHOTOS
12	A 1.09	EXISTING CONDITIONS
13	A 1.10	EXISTING NORTH/SOUTH ELEV.
14	A 1.11	EXISTING EAST/WEST ELEV.
15		RENDERING
16		RENDERING
17		RENDERING
18	A 1.12	F.A.R. CALCULATION
19	A 1.13	F.A.R. CALCULATION
20	A 2.00	SITE PLAN
21	A3.00	LEVEL 1
22	A3.01	LEVEL 2
23	A3.02	LEVEL 3
24	A3.03	LEVEL 4-5
25	A3.04	ROOF PLAN
26	A4.00	EXTERIOR ELEVATION
27	A4.01	EXTERIOR ELEVATION
28	A4.02	EXTERIOR ELEVATION
29	A4.03	EXTERIOR ELEVATION
30	A5.00	BUILDING SECTION
31	ALT 3.00	ALTERNATE PARKING LEVEL 1
32	ALT 3.01	ALTERNATE PARKING LEVEL 2
33	ALT 5.00	BUILDING SECTION
34	TD-1	TREE DISPOSITION PLAN
35	TD-2	TREE DISPOSITION PLAN
36	L-1	SITE LANDSCAPE PLAN
37	L-2	FOOR LEVEL SITE LANDSCAPE PLAJN
38	L-3	LANDSCAPE DETAILS
39	IRR-1	SITE IRRIGATION PLAN
40	IRR-2	IRRIGATION DETAILS
41	LL-1	LANDSCAPE LIGHTING PLAN
42	LL-2	LANDSCAPE LIGHTING DETAILS

MIAMI BEACH

Planning Department, 1700 Convention Center Drive
Miami Beach, Florida 33139, www.miamibeachfl.gov
305.673.7550

MULTIFAMILY - COMMERCIAL - ZONING DATA SHEET

ITEM #	Zoning Information			
1	Address:	1750 - 1716 ALTON RD, Miami Beach , FL 33139-2412		
2	Board and File numbers:			
3	Folio number(s):	02-3234-017-0030 02-3234-017-0020		
4	Year constructed:	1995	Zoning District:	CD-2 : GROUND/PEDESTAL RM-2 : TOWER
5	Base Flood Elevation:	8'-0" NGVD	Grade Value in NG	6.15 NGVD 6'-1-13/16"
6	Adjusted grade (Flood+Grade/2)	N/A	Lot Area:	1750 = 21,343, 1716= 7,500 28,843 SF TOTAL
7	Lot Width	150'-0"	Lot Depth:	209'-4"
8	Minimum Unit Size	300 SF	Average Unit Size:	N/A
9	Existing User	RETAIL	Proposed Use:	HOTEL / RETAIL / RESTAURANT

		Maximum	Existing	Proposed	Deficiencies
10	Height	50'-0"	19'-0"	53'-0"	3'-0"
11	Number of Stories	5 STORIES	1	5 STORIES	-
12	FAR 2.0	57,686 SF	7,522 SF	57,631 SF	-
13	Gross Square Footage	N/A	10,714 SF	83,234 SF	-
14	Square Footage by use	N/A	N/A	5,425 SF	-
15	Number of Units Residential	N/A	N/A	N/A	-
16	Number of Units Hotel	N/A	0	96	-
17	Number of Seats	N/A	0	160	-
18	Occupancy Load	N/A	N/A	233	-

	Setbacks	Required	Existing	Proposed	Deficiencies
	Subterranean:				
19	Front Setback:	N/A	N/A	N/A	-
20	Side Setback:	N/A	N/A	N/A	-
21	Side Setback:	N/A	N/A	N/A	-
22	Side Setback facing Street:	N/A	N/A	N/A	-
23	Rear Setback:	N/A	N/A	N/A	-
	At Grade Parking:				
24	Front Setback:	0'-0"	N/A	5'-0"	-
25	Side Setback:	0'-0"	N/A	5'-0"	-
26	Side Setback:	0'-0"	N/A	5'-0"	-
27	Side Setback facing Street:	0'-0"	N/A	5'-0"	-
28	Rear Setback:	0'-0"	N/A	5'-0"	-
	Pedestal 3-5				
29	Front Setback (East):	20'-0"	N/A	20'-0"	-
30	Side Setback (South):	16'-9"	N/A	16'-9"	-
31	Side Setback facing Street (West):	13'-0"	N/A	13'-0"	-
32	Rear Setback:	16'-9"	N/A	16'-9"	-

	Parking	Required	Existing	Proposed	Deficiencies
33	Parking District	6	6	6	-
34	Total # of parking spaces	88	18	57	-
35	20% PARKING REDUCTION (CENTRALIZED PARKING) SEE DIAGRAM PROVIDED	-17.6	-	-	-
36	Car Pool Spaces Ground Floor	-6			
37	10 Long Term Bike Rack	-2			
38	20 Short Term Bike Rack	-2			
39	2 Shower Facilities in Hotel	-4			
40	# of parking spaces per use (Provide a separate chart for a breakdown	SEE CHART PROVIDED	N/A	SEE CHART PROVIDED	-
41	# of parking spaces per level (Provide a separate chart for a	SEE CHART PROVIDED	N/A	SEE CHART PROVIDED	-
42	Parking Space Dimensions				-
43	Parking Space Configurations (45o, 60o, 90o, Parallel)	SEE CHART PROVIDED	N/A	SEE CHART PROVIDED	-
44	ADA Spaces	1	N/A	1	-
45	Tandem Spaces	N/A	N/A	N/A	-
46	Drive Aisle Width	22'	N/A	22'	-
47	Valet Drop off and pick up	11'	N/A	11'	-
48	Loading zones and Trash collection at Rocks	3	N/A	2 ONSITE / 1 ONSTREET	1 ONSTREET
49		25	N/A	31	-

	Restaurants, Cafes, Bars, Lounges, Nightclubs	Required	Existing	Proposed	Deficiencies
46	Type of use	N/A	RESTAURANT	RESTAURANT	-
47	Total # of Seats	N/A	N/A	160	-
48	Total # of Seats per venue (Provide a separate chart for a breakdown	N/A	N/A	40 (28 W / PARKING REDUCTION)	-
49	Total Occupant Content	N/A	N/A	233	-
50	Occupant content per venue (Provide a separate chart for a	N/A	N/A	233	-

51	Is this a contributing building?	NO
52	Located within a Local Historic District	NO

Notes: If not applicable write N/A
All other data information may be required and presented like the above format.
* SEE PARKING REQUIREMENTS (A)

REVISIONS / SUBMISSIONS	
1	
2	
3	
4	
5	
6	
7	
8	
9	
10	
11	
12	

1384

ALL DRAWINGS AND WRITTEN MATERIAL APPEARING HEREIN, CONSTITUTE THE ORIGINAL AND UNREPLICABLE WORK OF ASH KARP LLP, AND MAY NOT BE REPRODUCED, COPIED, OR DISCLOSED WITHOUT THE EXPRESS WRITTEN CONSENT OF ASH KARP ARCHITECTURE & INTERIOR DESIGN, INC. AIA (L) 2012

1750 ALTON HOTEL

1750 ALTON ROAD
MIAMI BEACH, FLORIDA 33139

INDEX & DATA

FINVARD GROUP

ASH KARP

OCT 20 2015

Lic. # AR001258

ARCHITECTURE
INTERIOR DESIGN
PLANNING

AIA ASID NCARB
2015 Biscayne Boulevard
Suite 200
Miami, Florida 33137
P. 305.673.7550
WWW.KOBIKARP.COM

K O B I K A R P

DRAWN BY:
CHECKED BY:
DATE:
APRIL 2012

A1.00

FOR
REFERENCE
ONLY
PB # 2279



Context Location Plan. Aerial Half Mile Radius

KIMPTON PALOMAR SOUTH BEACH

1750 Alton Road
Miami Beach, FL 33139

CONTEXT PHOTOS



FINVARB
GROUP



1 INTERSECTION BETWEEN ALTON RD AND DADE BLVD



2 ALTON RD INTERSECTION VIEW WEST



3 PROPERTY



KEY PLAN

KIMPTON PALOMAR SOUTH BEACH

1750 Alton Road

Miami Beach, FL 33139

CONTEXT PHOTOS



FINVARB
GROUP




4 ALTON RD S.W. VIEW



5 PROPERTY



6 ADJACENT SITE

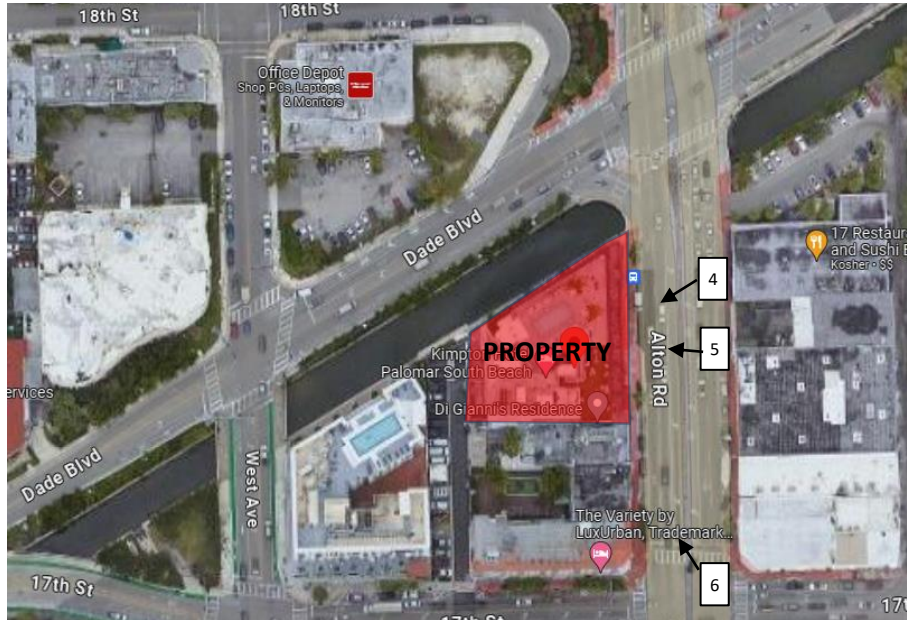

KEY PLAN

KIMPTON PALOMAR SOUTH BEACH

1750 Alton Road
Miami Beach, FL 33139

CONTEXT PHOTOS



FINVARB
GROUP



7 ALTON RD S.E. VIEW



8 ALTON RD S.E VIEW



9 ADJACENT SITE



KEY PLAN

KIMPTON PALOMAR SOUTH BEACH

1750 Alton Road
Miami Beach, FL 33139

CONTEXT PHOTOS





10 ALTON COURT LOOKING NORTH



11 ADJACENT HOTEL



12 WEST AVENUE BRIDGE / ADJACENT HOTEL



KEY PLAN

KIMPTON PALOMAR SOUTH BEACH

1750 Alton Road
Miami Beach, FL 33139

CONTEXT PHOTOS



FINVARB
GROUP



13 WEST AVENUE BRIDGE / ADJACENT HOTEL



14 ADJACENT HOTEL



15 PROPERTY



KEY PLAN

KIMPTON PALOMAR SOUTH BEACH

1750 Alton Road
Miami Beach, FL 33139

CONTEXT PHOTOS



FINVARB
GROUP




16 ALTON COURT WEST VIEW / ADJACENT HOTEL



17 ALTON COURT EAST VIEW / ADJACENT SITE



18 ALTON COURT EAST VIEW / PROPERTY

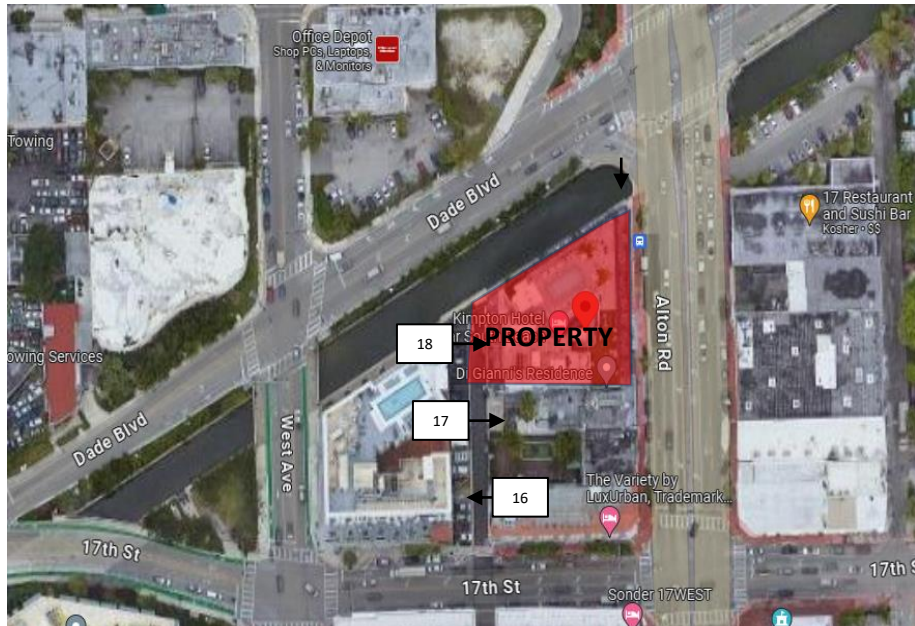

KEY PLAN

KIMPTON PALOMAR SOUTH BEACH

1750 Alton Road
Miami Beach, FL 33139

CONTEXT PHOTOS



FINVARB
GROUP



19

ALTON COURT / PROPERTY



20

ALTON RD / PROPERTY



21

ALTON RD / PROPERTY



KEY PLAN

KIMPTON PALOMAR SOUTH BEACH

1750 Alton Road
Miami Beach, FL 33139

CONTEXT PHOTOS



FINVARB
GROUP




1 ROOF TERRACE / SOUTH



2 ROOF TERRACE / NORTH



3 ROOF TERRACE / NORTH

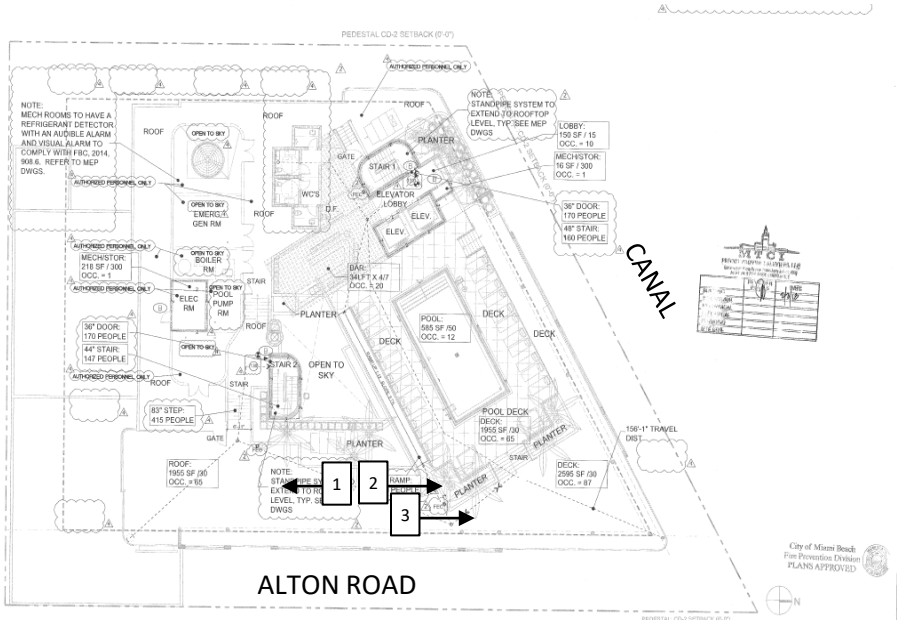

ROOF PLAN

KIMPTON PALOMAR SOUTH BEACH

1750 Alton Road
Miami Beach, FL 33139

ROOFTOP PHOTOS



FINVARB
GROUP




4 ROOF TERRACE / N.E. VIEW



5 ROOF TERRACE / NORTH VIEW



6 ROOF TERRACE / SOUTH WEST

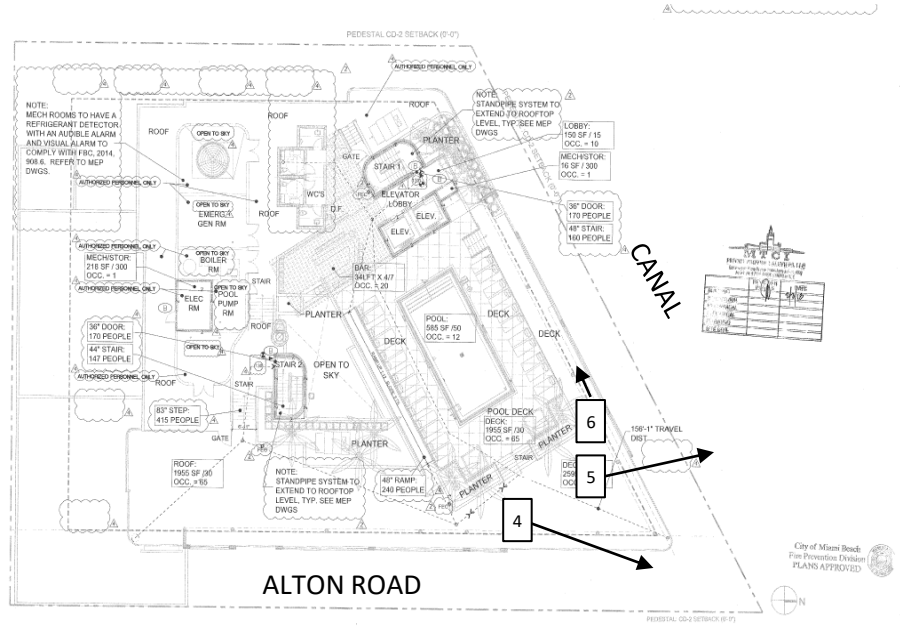

ROOF PLAN

KIMPTON PALOMAR SOUTH BEACH

1750 Alton Road
Miami Beach, FL 33139

ROOFTOP PHOTOS



FINVARB
GROUP




7 ROOF TERRACE / STAIRS TO POOL DECK



8 POOL DECK / SOUTH WEST



9 POOL DECK / NORTH EAST

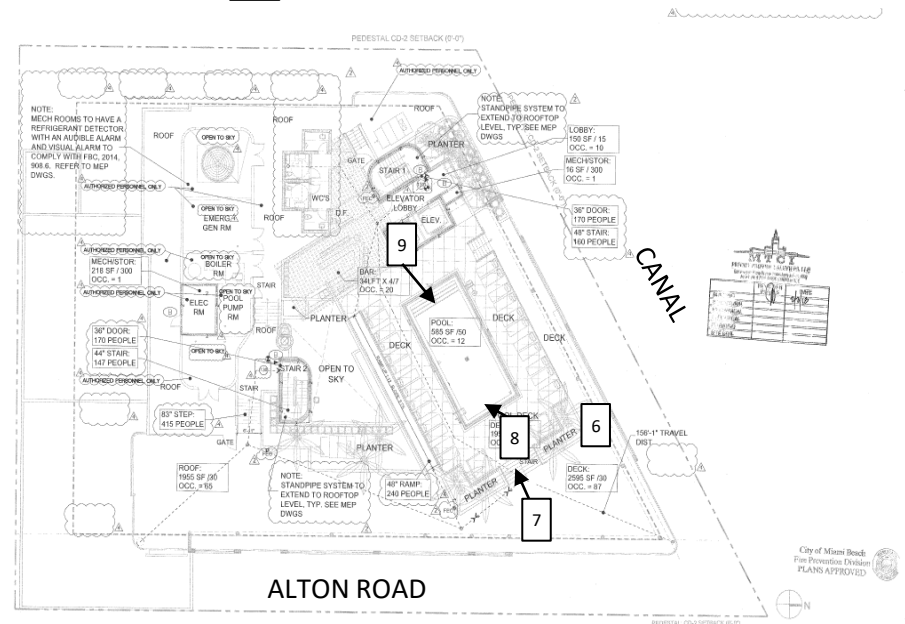

ROOF PLAN

KIMPTON PALOMAR SOUTH BEACH

1750 Alton Road
Miami Beach, FL 33139

ROOFTOP PHOTOS



FINVARB
GROUP



10

ROOFTOP 6-SEAT BAR




11

ROOFTOP RESTROOMS



12

POOL DECK / SOUTH WEST

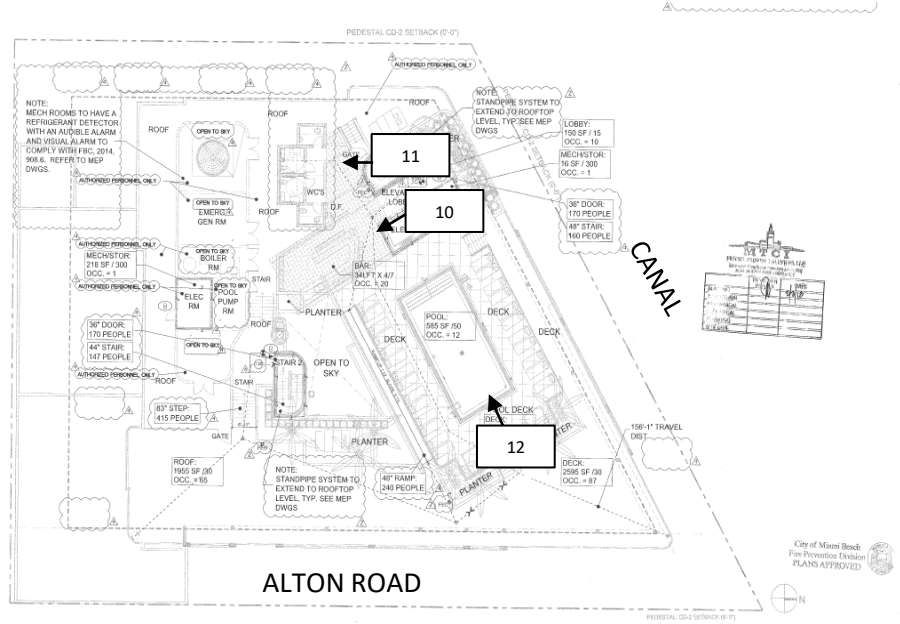

ROOF PLAN

KIMPTON PALOMAR SOUTH BEACH

1750 Alton Road
Miami Beach, FL 33139

ROOFTOP PHOTOS



FINVARB
GROUP

E BOULEVARD
(PUBLIC RIGHT OF WAY)

COLLINS CANAL

PROPOSED
WEST AVENUE
BRIDGE

35'-0" EASEMENT
32'-0" ALT. 2 BRIDGE

PARCELS "B"
8,465 SQ. FT. / 0.2 AC±

ADJACENT PROPERTY
5 STORY HOTEL BY MARRIOTT
(UNDER CONSTRUCTION)

ALTON COURT

NOCT

ASPHALT
PAVEMENT

17TH STREET
(PUBLIC RIGHT OF WAY)

ALTON RD.

PROPOSED 5 STORY BUILDING

LOCATION OF BACKFLOW PREVENTER

50'-0"

LOCATION OF P.I.V.

EXISTING 5 STORY BUILDING



SITE PLAN

Scale: 1/16" = 1'-0"

FOR REFERENCE
ONLY
PB # 2279

REVISIONS / SUBMISSIONS	
1	
2	
3	
4	
5	
6	
7	
8	
9	
10	
11	
12	

1384

ALL DRAWINGS AND WRITTEN MATERIAL APPEARING HEREIN
CONSTITUTE THE ORIGINAL AND UNREVISED WORK OF KOB
KARP AND MAY NOT BE REPRODUCED OR TRANSMITTED IN ANY FORM
WITHOUT THE EXPRESS WRITTEN CONSENT OF KOB KARP
ARCHITECTURE & INTERIOR DESIGN, INC. AIA #111715

1750 ALTON HOTEL
1750 ALTON ROAD
MIAMI BEACH, FLORIDA 33139

SITE PLAN



11


OCT 20 2015

ARCHITECTURE
INTERIOR DESIGN
PLANNING

AIA ASID NCARB

2015 Biscayne Boulevard
Suite 200
Miami, Florida 33137
P. 305.573.3766
F. 305.573.3766

WWW.KOBKARP.COM

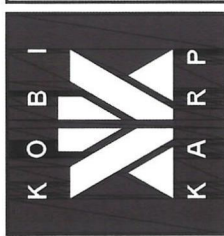

DRAWN BY:
CHECKED BY:

DATE: APRIL 2012

A2.00



LIFE SAFETY OCCUPANT LOAD CALCULATION - 1ST FLOOR				
ROOM	AREA	OCCUPANT LOAD FACTOR PER 1,000 SF	OCCUPANT LOAD	CATEGORY
LOBBY	1292 S.F.	15	88	HOTEL LOBBY
RECEPTION	125 S.F.	80	3	RECEPTION
MECH/STOR ROOMS	812 S.F.	300	2	STORAGE / MECH
RESTAURANT (INDOOR+KITCHEN)	3736 S.F.	15 / 100 (SEE ABOVE)	205	RESTAURANT
OFFICES	777 S.F.	100	8	BUSINESS
TOTAL =			304 PERSONS	4

Total Seat Count = 160

KIMPTON PALOMAR SOUTH BEACH

1750 Alton Road
Miami Beach, FL 33139


DIAGRAM PLANNING – FIRST FLOOR RESTAURANT



FINVARB
GROUP

Note: Not an architectural drawing. This is diagram planning for Planning Board purposes only. Occupancy loads are from As-Built drawings.

FOR REFERENCE
ONLY
PB # 2279

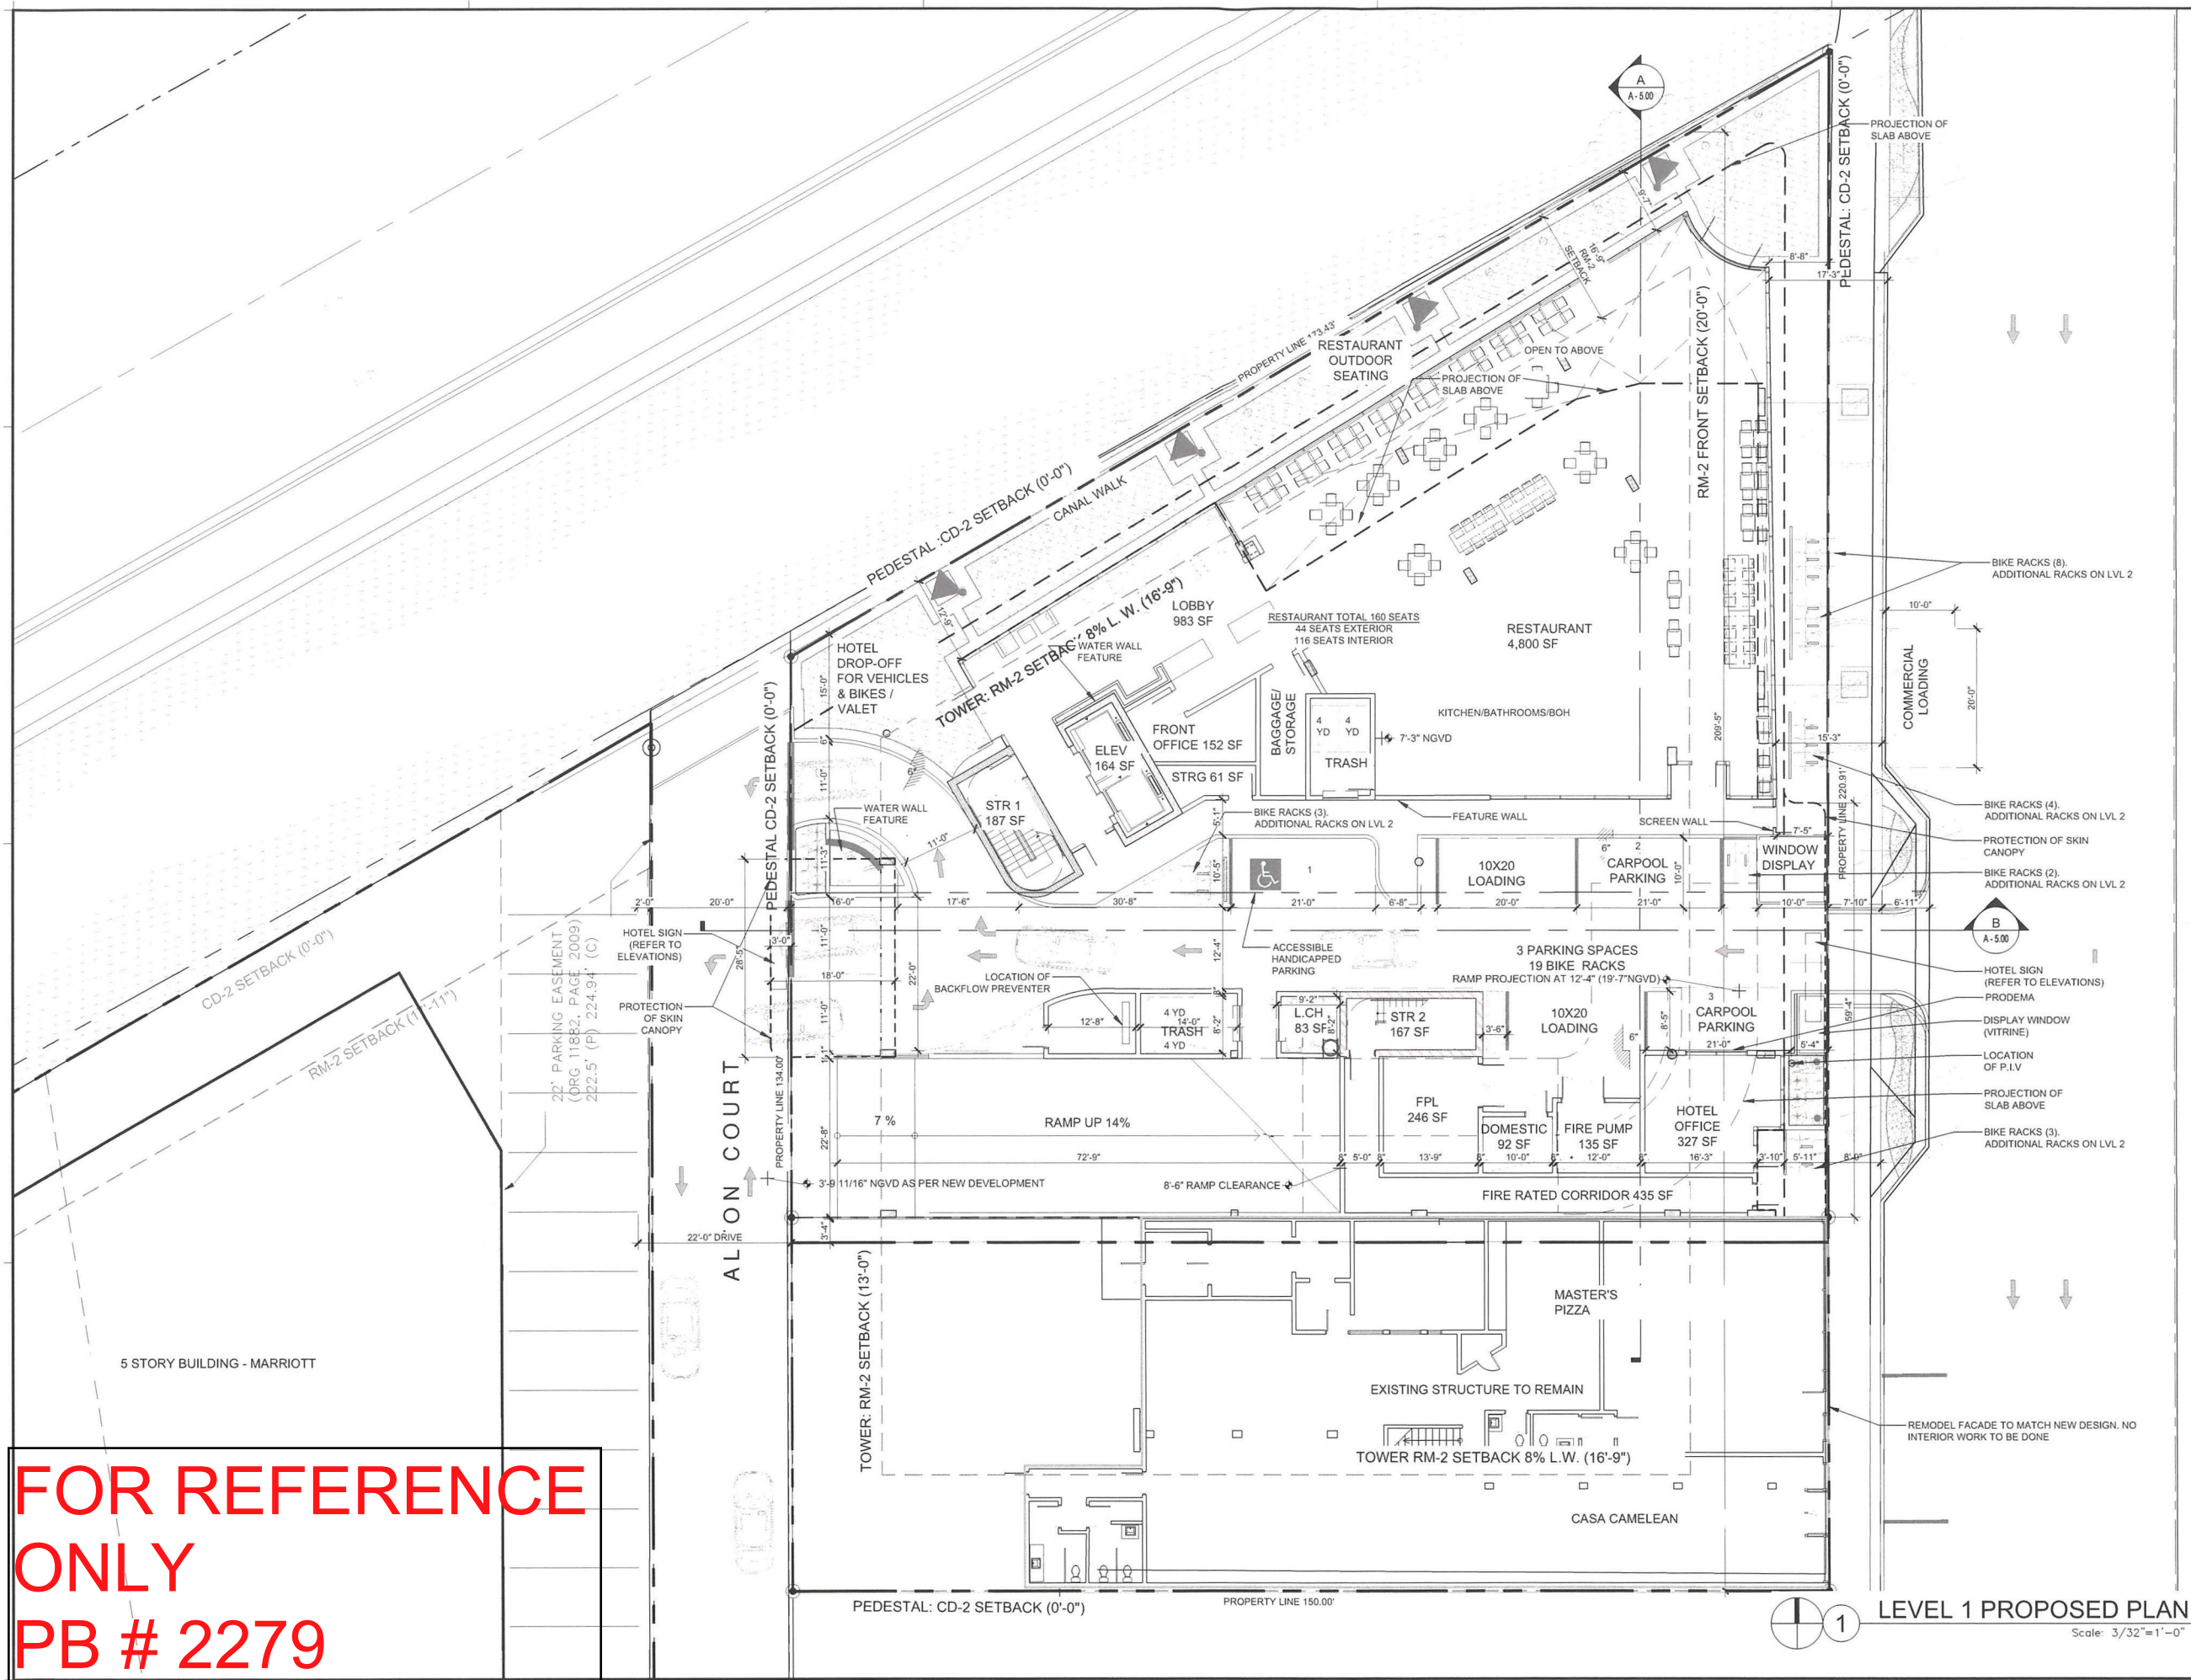

REVISIONS / SUBMISSIONS	
1	
2	
3	
4	
5	
6	
7	
8	
9	
10	
11	
12	

1384

ALL DRAWINGS AND WRITTEN MATERIAL APPEARING HEREIN
CONSTITUTE THE ORIGINAL AND UNREVISED WORK OF KOB
KARP AND MAY NOT BE REPRODUCED OR TRANSMITTED IN ANY FORM
WITHOUT THE EXPRESS WRITTEN CONSENT OF KOB KARP
ARCHITECTURE & INTERIOR DESIGN, INC. AIA # 2917

1750 ALTON HOTEL

1750 ALTON ROAD
MIAMI BEACH, FLORIDA 33139

LEVEL 1

FINVARB
GROUP


HA
Lic. # AR0002578
BCT 202015

ARCHITECTURE
INTERIOR DESIGN
PLANNING
AIA ASID NCARB
2315 Biscayne Boulevard
Suite 200
Miami, FL 33137
O: 305.573.1818
F: 305.573.3766
WWW.KOBKARP.COM

K O B I
K A R P

DRAWN BY:
CHECKED BY:
DATE: APRIL 2012

A3.00

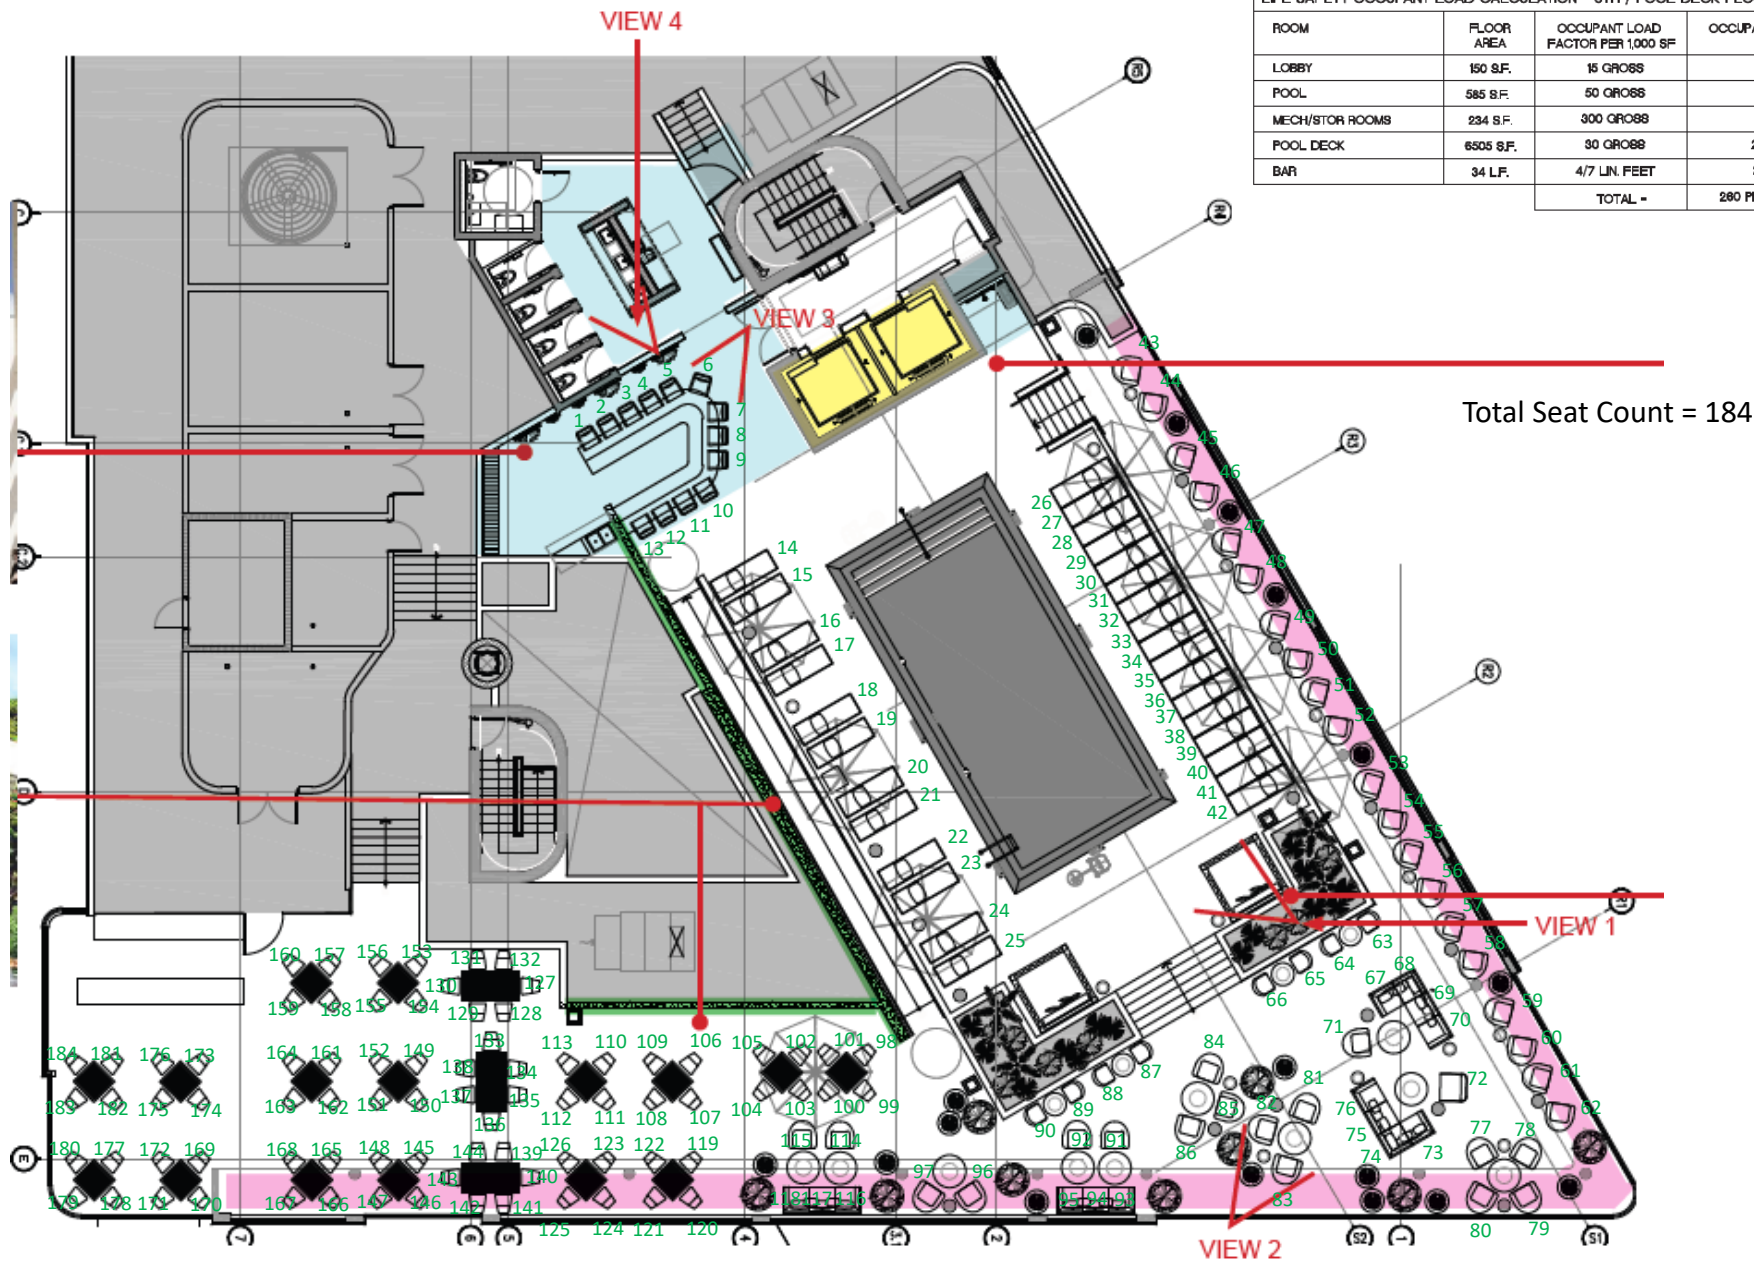

LIFE SAFETY OCCUPANT LOAD CALCULATION - 6TH / POOL DECK FLOOR - FBC, TABLE 1004.12

ROOM	FLOOR AREA	OCCUPANT LOAD FACTOR PER 1,000 SF	OCCUPANT LOAD	CATEGORY
LOBBY	150 S.F.	15 GROSS	10	LOBBY
POOL	585 S.F.	50 GROSS	12	POOL SURFACE
MECH/STOR ROOMS	234 S.F.	300 GROSS	1	STORAGE / MECH
POOL DECK	6505 S.F.	30 GROSS	217	POOL DECK
BAR	34 L.F.	4/7 LIN. FEET	20	BAR
TOTAL =			280 PERSONS	

KIMPTON PALOMAR SOUTH BEACH

1750 Alton Road
Miami Beach, FL 33139

DIAGRAM PLANNING – ROOFTOP

FINVARB
GROUP

Note: Not an architectural drawing. This is diagram planning for Planning Board purposes only. Occupancy loads are from As-Built drawings.

NOTES:

ALL EGRESS DOORS WITH $\frac{1}{2}$ " MAX ELEVATION. TYPICAL.

PLUMBING FIXTURE CALCULATION - POOL DECK FLOOR - FBC, TABLE 403.6				
ROOM	OCCUPANT LOAD	$\frac{1}{2}$ MALE	$\frac{1}{2}$ FEMALE	LAVS
LOBBY	10 PEOPLE	130 PEOPLE	130 PEOPLE	1 PER 200 PERSONS
SWIMMING POOL	12 PEOPLE			
MECH/STOR ROOMS	1 PERSON	2 WCS	2 WCS	2 LAVS
POOL DECK	217 PEOPLE			
BAR	20 PEOPLE			
TOTALS:	260 PEOPLE	4 WCS		2 LAVS


LIFE SAFETY OCCUPANT LOAD CALCULATION - 6TH / POOL DECK FLOOR - FBC, TABLE 1004.12				
ROOM	FLOOR AREA	OCCUPANT LOAD FACTOR PER 1,000 SF	OCCUPANT LOAD	CATEGORY
LOBBY	150 S.F.	15 GROSS	10	LOBBY
POOL	585 S.F.	50 GROSS	12	POOL SURFACE
MECH/STOR ROOMS	234 S.F.	300 GROSS	1	STORAGE / MECH
POOL DECK	6505 S.F.	30 GROSS	217	POOL DECK
BAR	34 L.F.	4/7 LIN. FEET	20	BAR
TOTAL =			260 PERSONS	

DOOR AND STAIR EGRESS - 6TH FLOOR / ROOF - 260 PERSONS				
REQUIRED DOOR, 0.2" MIN. WIDTH REQUIRED	REQUIRED STAIR, 0.3" MIN. WIDTH REQUIRED	PROVIDED DOOR, 0.2" MIN. WIDTH REQUIRED	STAIR, 0.3" MIN. WIDTH REQUIRED	
54.4" WIDTH	81.6" WIDTH	(2) AT 32" WIDTH = 64"	(2) AT 44" WIDTH = 88"	
TOTAL =			260 PERSONS	

**FOR
REFERENCE
ONLY
BC1703462**

A1 LIFE SAFETY PLAN - ROOF / 6TH FLOOR

SCALE: 3/32" = 1'-0"

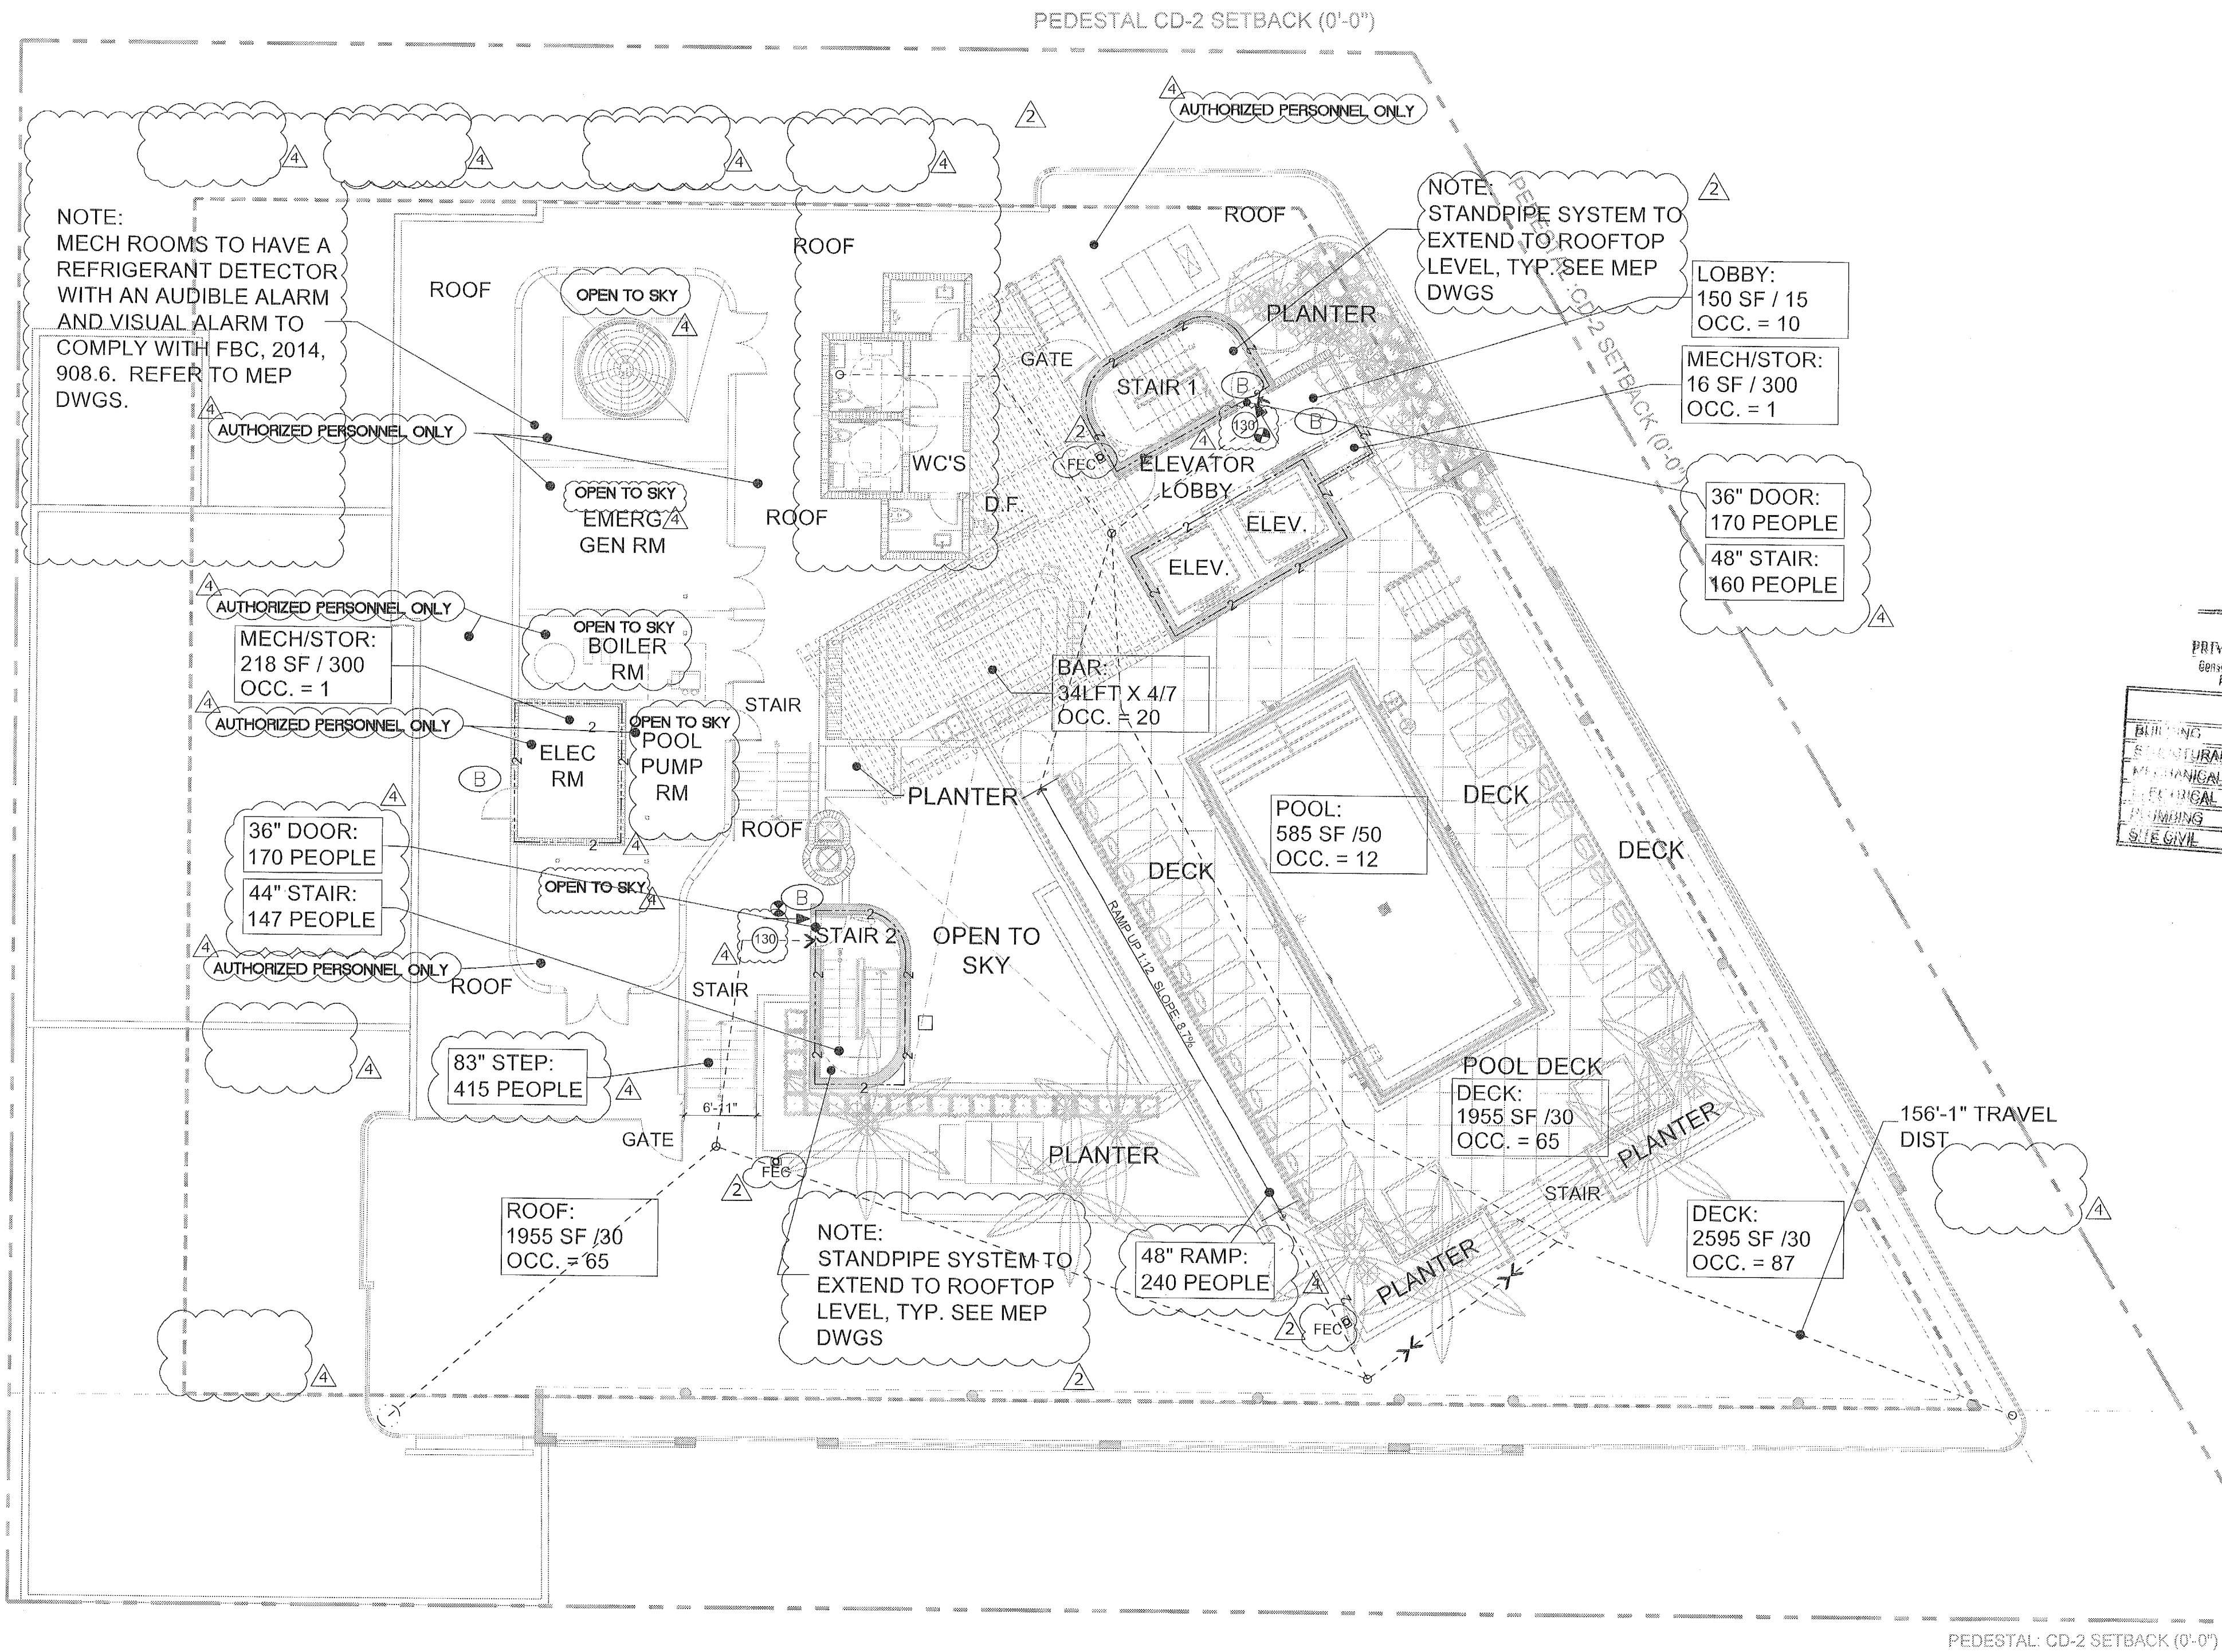

KEY MAP
N.T.S.



City of Miami Beach
Fire Prevention Division
PLANS APPROVED



PERMUY

ARCHITECTURE
INTERIOR DESIGN
PLANNING

2717 Ponce de Leon Blvd.
Coral Gables, FL 33134
Phone : 305.200.5302
www.PermuyArchitecture.com

STATE OF FLORIDA
HELIO MILIAN ARCHITECT
REGISTRATION #48044603
THESE DESIGNS AND DRAWINGS ARE THE
COPYRIGHTED PROPERTY OF PERMUY
ARCHITECTURE INTERIOR DESIGN AND
PLANNING, INC. AND MAY NOT BE REPRODUCED
EXCEPT WITH SPECIFICATION WRITTEN
CONSENT OF THE ARCHITECT. THE
CONTRACTOR MUST CHECK AND VERIFY ALL
DIMENSIONS OF THE JOB AND BE RESPONSIBLE
FOR SAME. REPORTING ANY DISCREPANCIES TO
THE ARCHITECT BEFORE COMMENCING WORK.
DRAWINGS ARE NOT TO BE SCALED

KIMPTON HOTEL
PALOMAR
SOUTH BEACH
1750 Alton Road, Miami Beach, FL 33139

FINVARB GROUP

1005 Kane Concourse, Suite 201, Bay Harbor Island, FL 33154

No.	DESCRIPTION	DATE
	PERMIT SET	02.28.17
REV. 2		04.28.17
REV. 4		11.22.17

PROJECT NO:
1613

DATE:
02.28.17

SHEET INDEX:

SCALE:
As Noted

SHEET NO:

A-024

GENERAL NOTE :

1. COOLING TOWER, EMERGENCY GENERATOR ROOM, BOILER ROOM, POOL, EQUIPMENT ROOM & STORAGE ROOM HAVE NO ROOF STRUCTURE & ARE OPEN TO SKY.
2. ALL TRASH CONTAINERS SHALL UTILIZE RUBBER WHEELS, OR THE PATH FOR THE TRASH CONTAINERS SHALL BE PLAYED VOLUME AT A VOLUME THAT IS FLAINLY AUDIBLE FROM OTHER PROPERTIES AND WHICH INTERFERES WITH NORMAL CONVERSATION.
3. SIGN TO READ: THE POOL DECK SHALL BE CLOSED TO BETWEEN THE HOURS OF MIDNIGHT AND 6 AM.
4. EXCEPT AS MAY BE REQUIRED FOR SECURITY, FIRE OR BUILDING CODE/ LIFE SAFETY CODE REASONS, NO SEPARATORS SHALL BE AFFIXED TO OR OTHERWISE LOCATED ON THE EXTERIOR OF THE BUILDING SHALL BE PLAYED VOLUME AT A VOLUME THAT IS FLAINLY AUDIBLE FROM OTHER PROPERTIES AND WHICH INTERFERES WITH NORMAL CONVERSATION.
5. ALL HANDRAILS TO COMPLY WITH NFPA 5TH EDITION SECTION 7.2.2.4.4.9
6. USE OF THE ROOFTOP POOL DECK SHALL BE LIMITED TO THE EXCLUSIVE USE OF HOTEL GUESTS AND THEIR INVITEES.

- LIGHTING NOTE:**
1. ALL ROOFTOP LIGHTING SHALL CONSIST OF A LIGHTING FIXTURE THAT IS AFFIXED TO AND NO HIGHER THAN THE ROOFTOP PARAPET WALL.
 2. All roof top lighting fixtures shall be designed to preclude light spilling over to adjacent properties, in a manner to be reviewed and approved by staff—consistent with the Design Review Criteria and/or the directions from the Board.

FLOOR	GROSS CONST AREA (SLAB AREA)	ENCLOSED AREA (A/C SPACE)	ENTRY DRIVE	CANAL WALKWAY	BALCONY	TERRACE	POOL DECK (FIN. DECK)	MECH ROOMS	STAIRS
1ST	15,025	8,210	5,045	2,802	0	0	0	410	412
2ND	14,999	1,945	0	0	0	0	0	0	412
3RD	18,783	13,120	0	0	202	4,923	0	65	341
4TH	14,649	13,120	0	0	1,529	0	0	65	341
5TH	14,649	13,120	0	0	1,529	0	0	65	341
6TH/POOL	14,649	648	0	0	0	0	8,574	220	337
HIGH ROOF	1,211								
Sub-Totals:	93,965	50,163	5,045	2,802	3,260	4,923	8,574	825	2,184


PERMUY
ARCHITECTURE
INTERIOR DESIGN
PLANNING

2717 Ponce de Leon Blvd.
Coral Gables, FL 33134
Phone : 305.200.5302
www.PermuyArchitecture.com

STATE OF FLORIDA
SEAL OF MICHIGAN ARCHITECT
REGISTRATION #450006953

THESE DESIGNS AND DRAWINGS ARE THE
COPYRIGHTED PROPERTY OF PERMUY
ARCHITECTURE INTERIOR DESIGN AND
PLANNING, INC. AND MAY NOT BE REPRODUCED
OR COPIED IN ANY MANNER WITHOUT THE
WRITTEN CONSENT OF THE ARCHITECT. THE
CONTRACTOR MUST CHECK AND VERIFY ALL
DIMENSIONS OF THE JOB TO BE RESPONSIBLE
FOR SAME. REPORTING ANY DISCREPANCY TO
THE ARCHITECT BEFORE COMMENCING WORK.
DRAWINGS ARE NOT TO BE SCALED

KIMPTON HOTEL
PALOMAR
SOUTH BEACH
1750 Alton Road, Miami Beach, FL 33139
FINVARB GROUP
1085 Kane Concourse, Suite 201, Bay Harbor Island, FL 33154

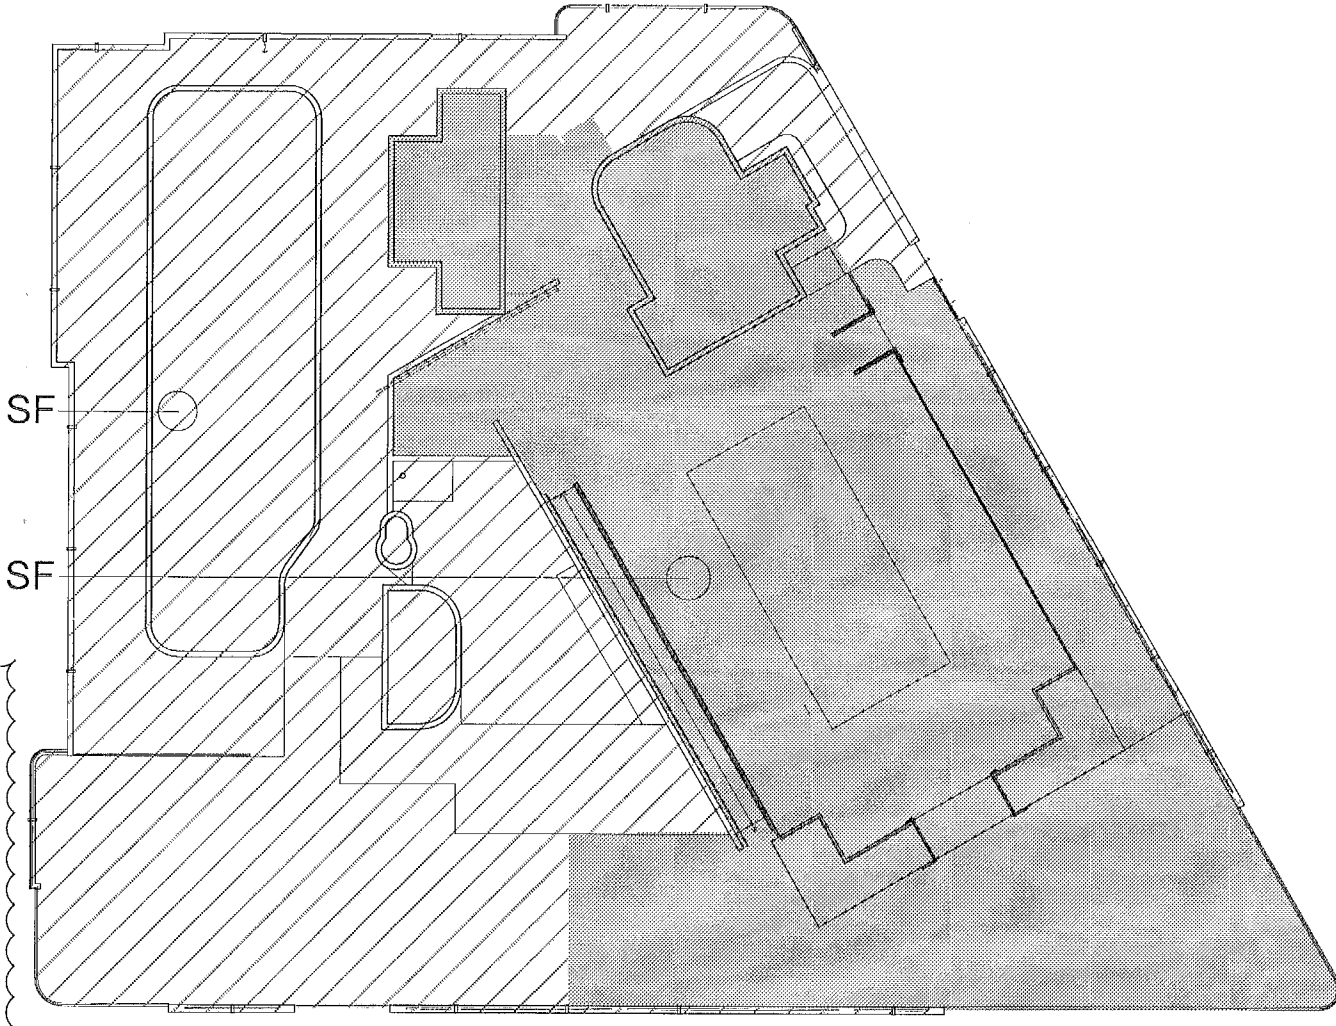

ROOFTOP AREA = 14,649 SF
OCCUPIED AREA = 7,320 SF

IN COMPLIANCE WITH 2014 FBCB 454.1.5
454.1.5.1 EQUIPMENT AREA OR ROOMS.
EQUIPMENT DESIGNATED BY THE MANUFACTURER FOR OUTDOOR
USE MAY BE LOCATED IN AN EQUIPMENT AREA. ALL OTHER
EQUIPMENT MUST BE LOCATED IN AN EQUIPMENT ROOM OR
ENCLOSURE. PLASTIC PIPE SUBJECT TO A PERIOD OF
PROLONGED SUNLIGHT EXPOSURE MUST BE COATED TO
PROTECT IT FROM ULTRAVIOLET LIGHT DEGRADATION. AN
EQUIPMENT AREA SHALL BE SURROUNDED WITH A FENCE AT
LEAST 4 FEET (1219 MM) HIGH ON ALL SIDES NOT CONFINED
BY A BUILDING OR EQUIVALENT STRUCTURE. A SELF-CLOSING
AND SELF-LATCHING GATE WITH A PERMANENT LOCKING DEVICE
SHALL BE PROVIDED IF NECESSARY FOR ACCESS. AN
EQUIPMENT ROOM SHALL BE PROTECTED ON AT LEAST THREE
SIDES AND OVERHEAD. ANY FENCE OR GATE INSTALLED SHALL
USE MEMBERS SPACING THAT SHALL NOT ALLOW PASSAGE OF
A 4-INCH (102 MM) DIAMETER SPHERE. THE FOURTH SIDE MAY
BE A GATE, FENCE, OR OPEN IF OTHERWISE PROTECTED FROM
UNAUTHORIZED ENTRANCE. AN EQUIPMENT ENCLOSURE SHALL
BE LOCKABLE OR OTHERWISE PROTECTED FROM UNAUTHORIZED
ACCESS.

454.1.5.2 INDOOR EQUIPMENT.
EQUIPMENT NOT DESIGNATED BY THE MANUFACTURER FOR
OUTDOOR USE SHALL BE LOCATED IN AN EQUIPMENT ROOM. AN
EQUIPMENT ROOM SHALL BE PROTECTED ON AT LEAST THREE
SIDES AND OVERHEAD. THE FOURTH SIDE MAY BE A GATE,
FENCE, OR OPEN IF OTHERWISE PROTECTED FROM
UNAUTHORIZED ENTRANCE.

454.1.5.3 MATERIALS.
THE EQUIPMENT ENCLOSURE, AREA OR ROOM FLOOR SHALL BE
OF CONCRETE OR OTHER NONABSORBENT MATERIAL HAVING A
SMOOTH SLIP-RESISTANT FINISH AND SHALL HAVE POSITIVE
DRAINAGE, INCLUDING A SUMP PUMP IF NECESSARY. ANCILLARY
EQUIPMENT, SUCH AS A HEATER, NOT CONTAINED IN AN
EQUIPMENT ENCLOSURE OR ROOM SHALL NECESSITATE AN
EQUIPMENT AREA AS DESCRIBED ABOVE.

454.1.5.4 VENTILATION.
EQUIPMENT ROOMS SHALL HAVE EITHER FORCED DRAFT OR
CROSS VENTILATION. ALL BELOW-GRADE EQUIPMENT ROOMS
SHALL HAVE A STAIRWAY ACCESS WITH FORCED DRAFT
VENTILATION OR A FULLY LOUVERED DOOR AND POWERED
INTAKE WITHIN 6 INCHES (152 MM) OF THE FLOOR, WHERE
STAIRWAY ACCESS IS NOT NECESSARY TO CARRY HEAVY ITEMS
INTO THE BELOW GRADE ROOM OR VAULT, A "SHIP'S
LADDER" MAY BE USED IF SPECIFIED BY THE DESIGN ENGINEER
WHO MUST CONSIDER ANTICIPATED WORKLOAD INCLUDING
EQUIPMENT REMOVAL, AND THE LADDER SLOPE, TREAD HEIGHT
AND WIDTH, AND CONSTRUCTION MATERIAL OF THE LADDER.

454.1.5.5 ACCESS.
THE OPENING TO AN EQUIPMENT ROOM OR AREA SHALL BE A
MINIMUM 3 FEET BY 6 FEET (914 MM BY 1829 MM) AND SHALL
PROVIDE EASY ACCESS TO THE EQUIPMENT.

454.1.5.6 SIZE.
THE SIZE OF THE EQUIPMENT ENCLOSURE, ROOM OR AREA
SHALL PROVIDE WORKING SPACE TO PERFORM ROUTINE
OPERATIONS. CLEARANCE SHALL BE PROVIDED FOR ALL
EQUIPMENT AS PRESCRIBED BY THE MANUFACTURER TO ALLOW
NORMAL MAINTENANCE OPERATION AND REMOVAL WITHOUT
DISTURBING OTHER PIPING OR EQUIPMENT. IN ROOMS WITH
FIXED CEILINGS, THE MINIMUM HEIGHT SHALL BE 7 FEET (2137
MM).

454.1.5.7 LIGHTING.
EQUIPMENT ROOMS OR AREAS SHALL BE LIGHTED TO PROVIDE
30 FOOT-CANDLES (300 LUX) OF ILLUMINATION AT FLOOR LEVEL.
454.1.5.8 STORAGE.
EQUIPMENT ENCLOSURES, ROOMS OR AREAS SHALL NOT BE
USED FOR STORAGE OF CHEMICALS EMITTING CORROSIVE FUMES
OR FOR STORAGE OF OTHER ITEMS TO THE EXTENT THAT
ENTRANCE TO THE ROOM FOR INSPECTION OR OPERATION OF
THE EQUIPMENT IS IMPAIRED.

454.1.5.9 HOSE BIBBS.
A HOSE BIBB WITH VACUUM BREAKER SHALL BE LOCATED IN
THE EQUIPMENT ROOM OR AREA.

No.	DESCRIPTION	DATE
1	PERMIT SET	02.28.17
2	REV. 2	05.31.17
3	BLDG. INTL. COMMENTS	08.01.17
4	REV. 4	11.22.17

PROJECT NO. 1613
DATE: 02.28.17
SHEET INDEX:
As Noted

MTCT
Construction Plans Review, Inspection & Consulting
REVIEWED FOR C.C. PLAN

PRIVATE PROVIDER SERVICES, LLC
Construction Plans Review, Inspection & Consulting
REVIEWED FOR C.C. PLAN

BUILDING
STR. 1
MTCT

**FOR
REFERENCE
ONLY
BC1703462**

A1 LOWER ROOF PLAN

SCALE: 1/8" = 1'-0"

PROPERTY LINE 220.91'

PEDESTAL: CD-2 SETBACK (0'-0")

PEDESTAL: CD-2 SETBACK (0'-0")

PROPERTY LINE 150.00'

PROPERTY LINE 134.00'

PEDESTAL CD-2 SETBACK (0'-0")


RM-2 SETBACK

PEDESTAL: CD-2 SETBACK (0'-0")

ROOFTOP AREA = 14,649 SF
OCCUPIED AREA = 7,320 SF

OCCUPANCY DIAGRAM - ROOF TOP
NTS

PEDESTAL: CD-2 SETBACK (0'-0")

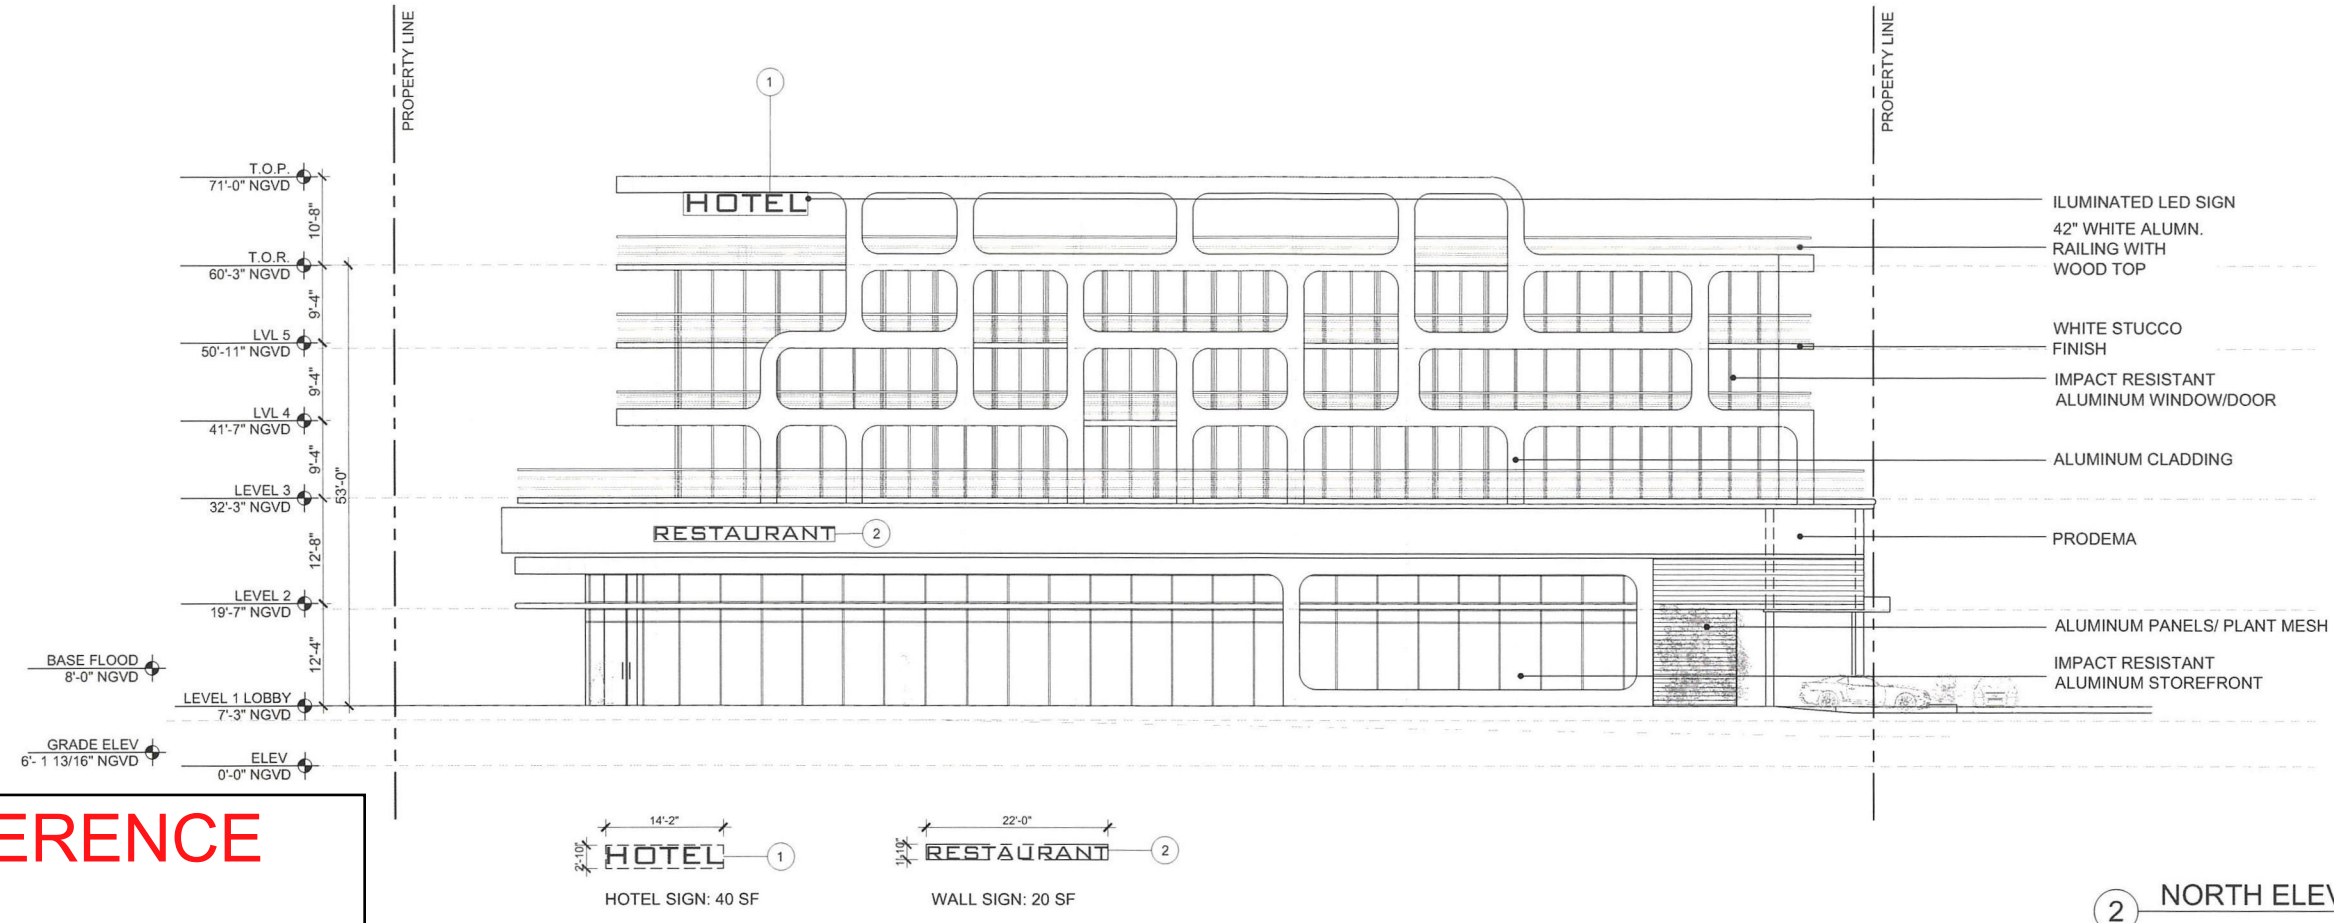


FOR REFERENCE ONLY
PB # 2279

REVISIONS / SUBMISSIONS	
1	
2	
3	
4	
5	
6	
7	
8	
9	
10	
11	
12	


1384
ALL DRAWINGS AND WRITTEN MATERIAL APPEARING HEREIN CONSTITUTE THE ORIGINAL AND UNPUBLISHED WORK OF KOB KARP AIA, AND MAY NOT BE DUPLICATED, USED, OR DISCLOSED WITHOUT THE EXPRESS WRITTEN CONSENT OF KOB KARP ARCHITECTURE & INTERIOR DESIGN, INC. AIA #12102

1750 ALTON HOTEL
1750 ALTON ROAD
MIAMI BEACH, FLORIDA 33139
NORTH ELEVATION

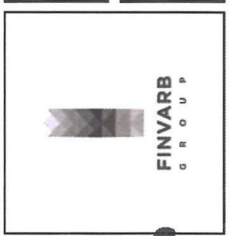




11
001-2024-03
Lic. # AR0012578

ARCHITECTURE
INTERIOR DESIGN
PLANNING
AIA ASID NCARB
2315 Biscayne Boulevard
Suite 200
Miami Beach, FL 33137
P: 305.573.3766
F: 305.573.3766
WWW.KOBKARP.COM

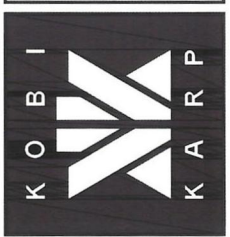

DRAWN BY:
CHECKED BY:
DATE: APRIL 2012

A4.00

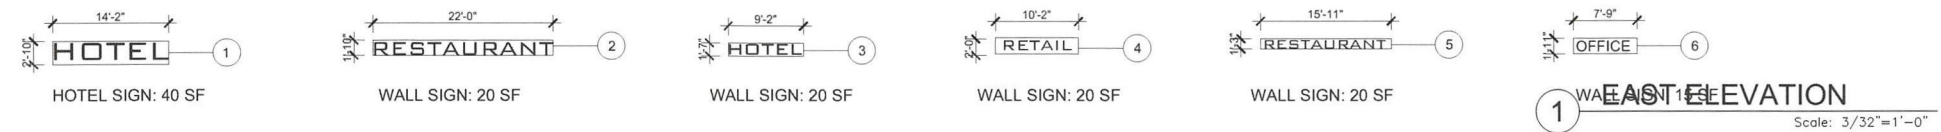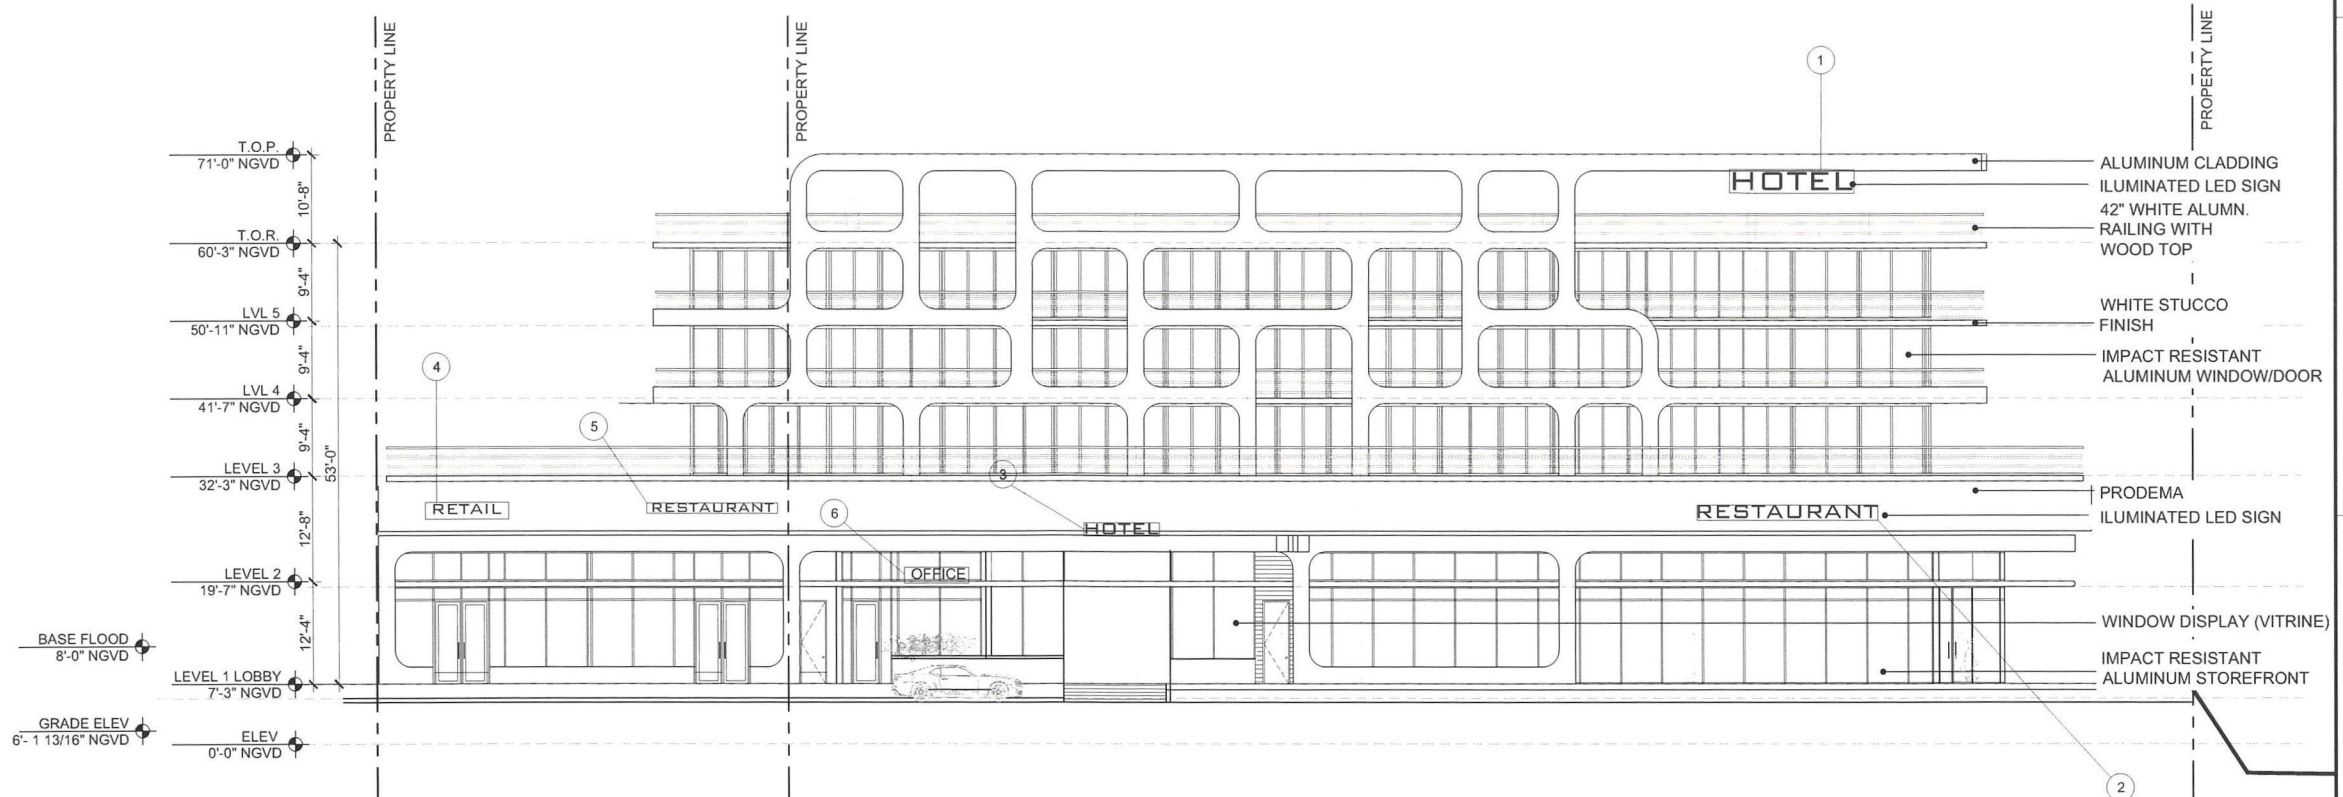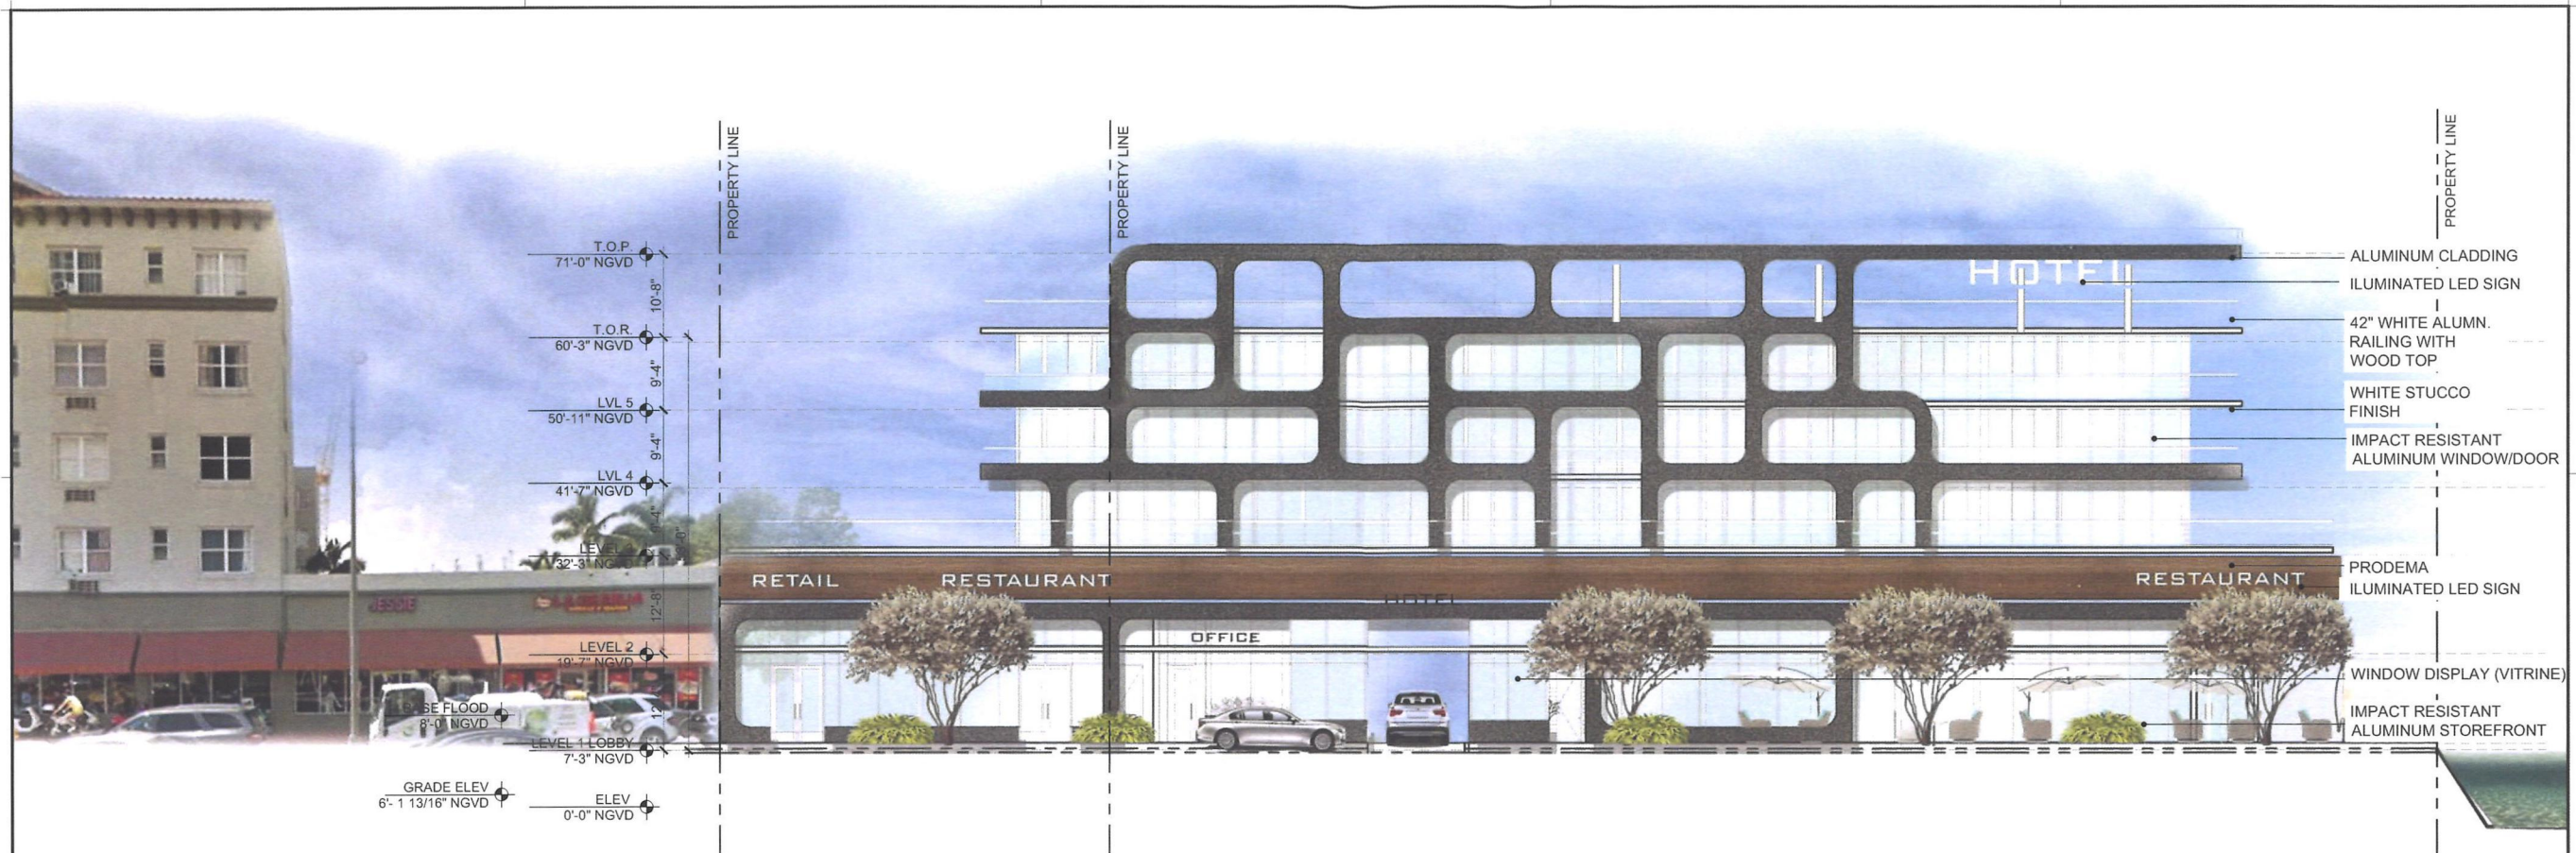

FOR REFERENCE
ONLY
PB # 2279

REVISIONS / SUBMISSIONS	
1	
2	
3	
4	
5	
6	
7	
8	
9	
10	
11	
12	

1384

ALL DRAWINGS AND WRITTEN MATERIAL APPEARING HEREIN CONSTITUTE THE ORIGINAL AND UNPUBLISHED WORK OF KOBIKARP AIA, AND MAY NOT BE DUPLICATED, USED, OR DISCLOSED WITHOUT THE EXPRESSED WRITTEN CONSENT OF KOBIKARP ARCHITECTURE & INTERIOR DESIGN, INC. AIA (R) 2012

1750 ALTON HOTEL
1750 ALTON ROAD
MIAMI BEACH, FLORIDA 33139

EAST ELEVATION

FINVARB GROUP

OCT 20 2015

Lic. # AR0012578

ARCHITECTURE
INTERIOR DESIGN
PLANNING

AIA ASID NCARB
2315 Biscayne Boulevard
Suite 200 33137
Miami, FL 33133
O: 305.573.1818
F: 305.573.3766
WWW.KOBIKARP.COM



K O B I K A R P

DRAWN BY:

CHECKED BY:

DATE: APRIL 2012

A4.01

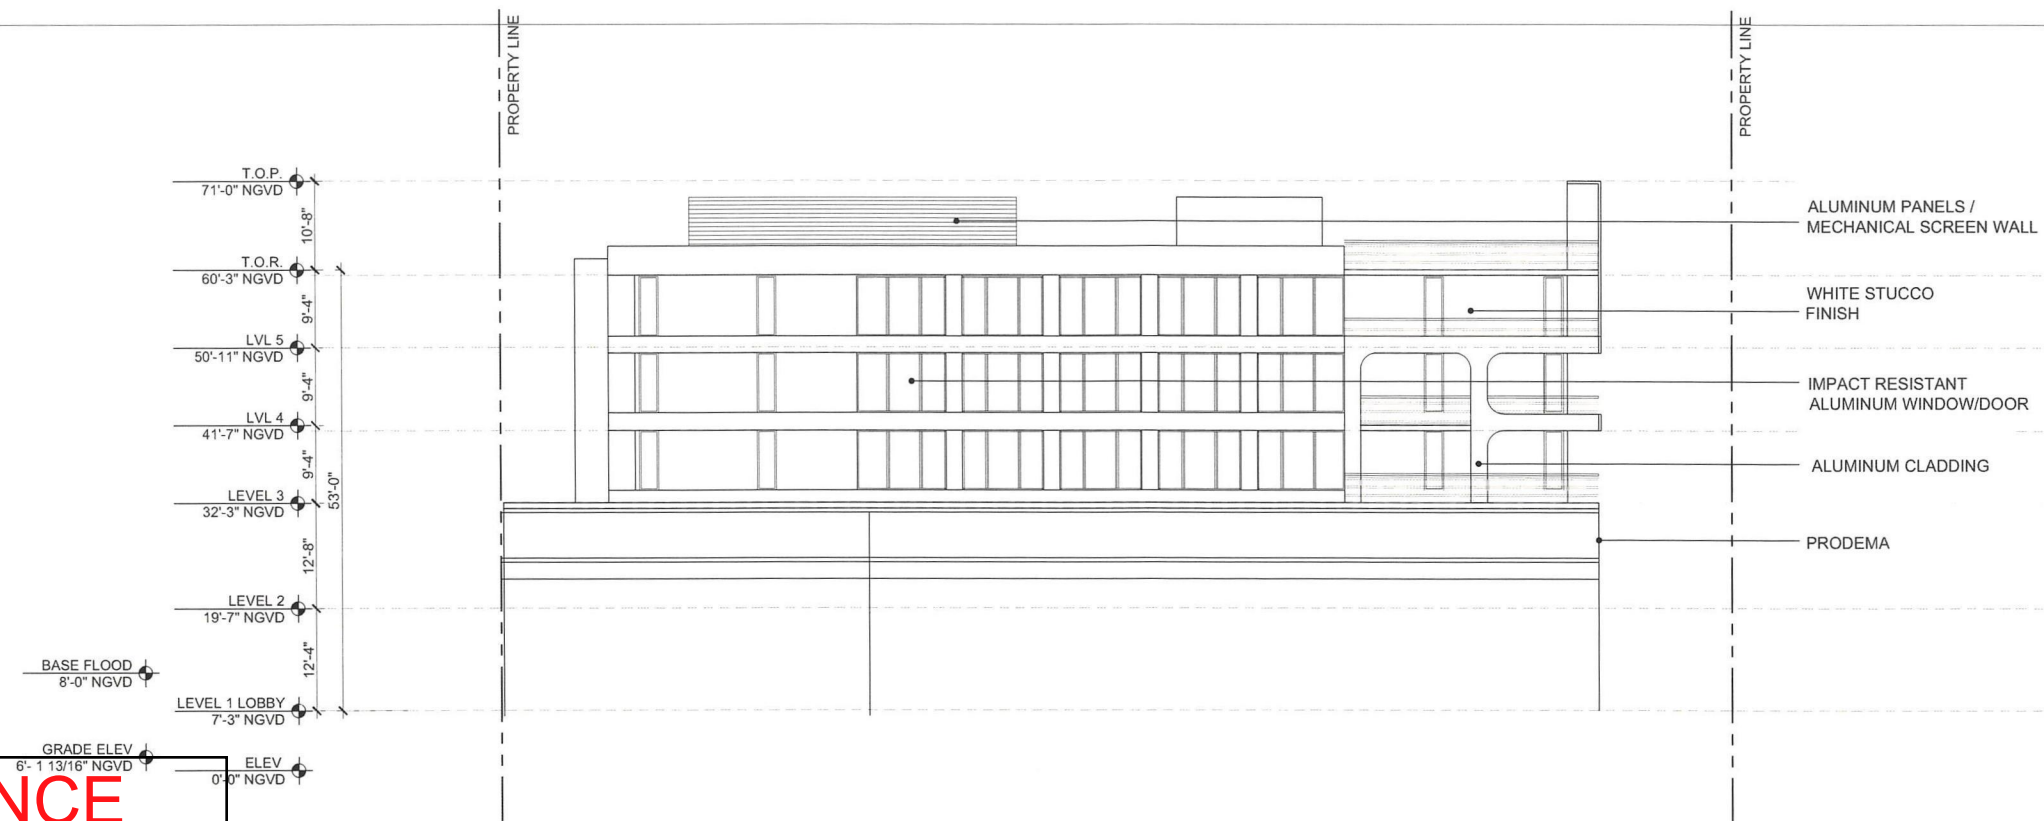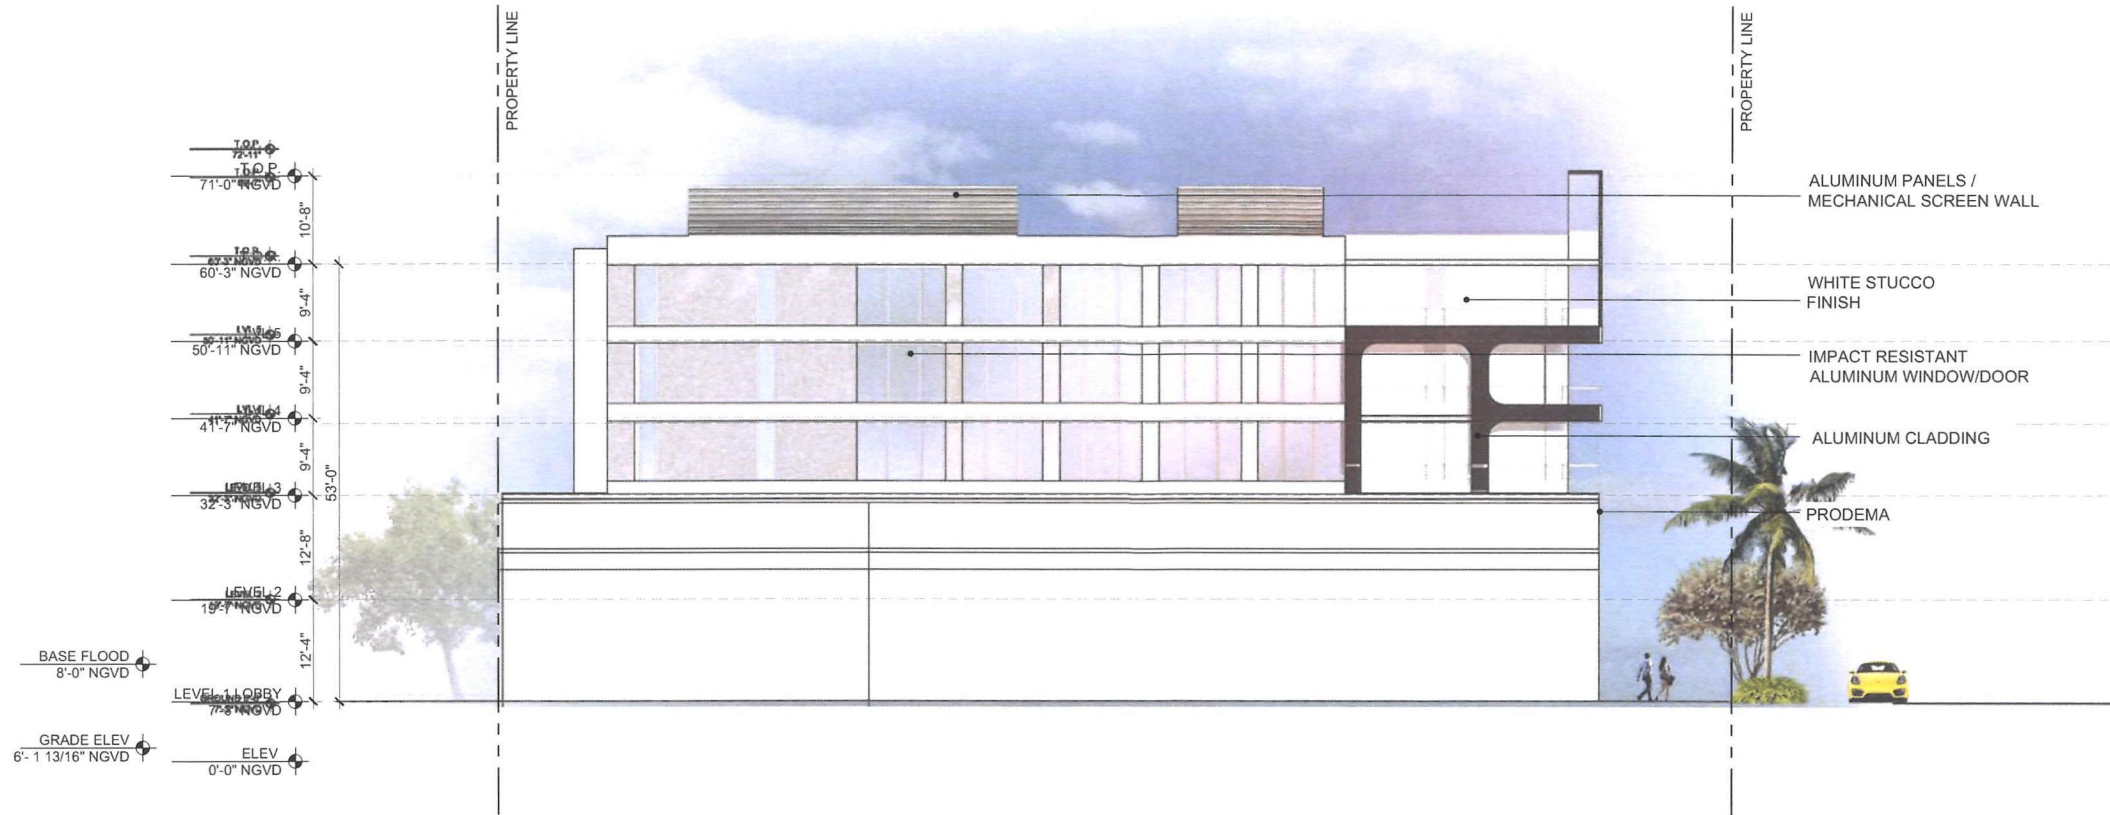

1 SOUTH ELEVATION
Scale: 3/32"=1'-0"

REVISIONS / SUBMISSIONS	
1	-
2	-
3	-
4	-
5	-
6	-
7	-
8	-
9	-
10	-
11	-
12	-

1384

ALL DRAWINGS AND WRITTEN MATERIAL APPEARING HEREIN
CONSTITUTE THE ORIGINAL AND UNREPEATED WORK OF KOB
KARP AIA, AND MAY NOT BE DUPLICATED, USED, OR DISCLOSED
WITHOUT THE EXPRESSED WRITTEN CONSENT OF KOB KARP
ARCHITECTURE & INTERIOR DESIGN, INC. AIA 105 2015

1750 ALTON HOTEL
1750 ALTON ROAD
MIAMI BEACH, FLORIDA 33139

SOUTH ELEVATION

FINVARB
GROUP

LL
OCT 20 2015
Lic. # AR00125B

ARCHITECTURE
INTERIOR DESIGN
PLANNING
AIA ASID NCARB
2015 Biscayne Boulevard
Miami, Florida 33137
O: 305.573.1818
F: 305.573.3766
WWW.KOBKARP.COM


K O B I
K A R P

DRAWN BY:
CHECKED BY:
DATE: APRIL 2012

A4.02

FOR REFERENCE
ONLY
PB # 2279

FOR REFERENCE
ONLY
PB # 2279

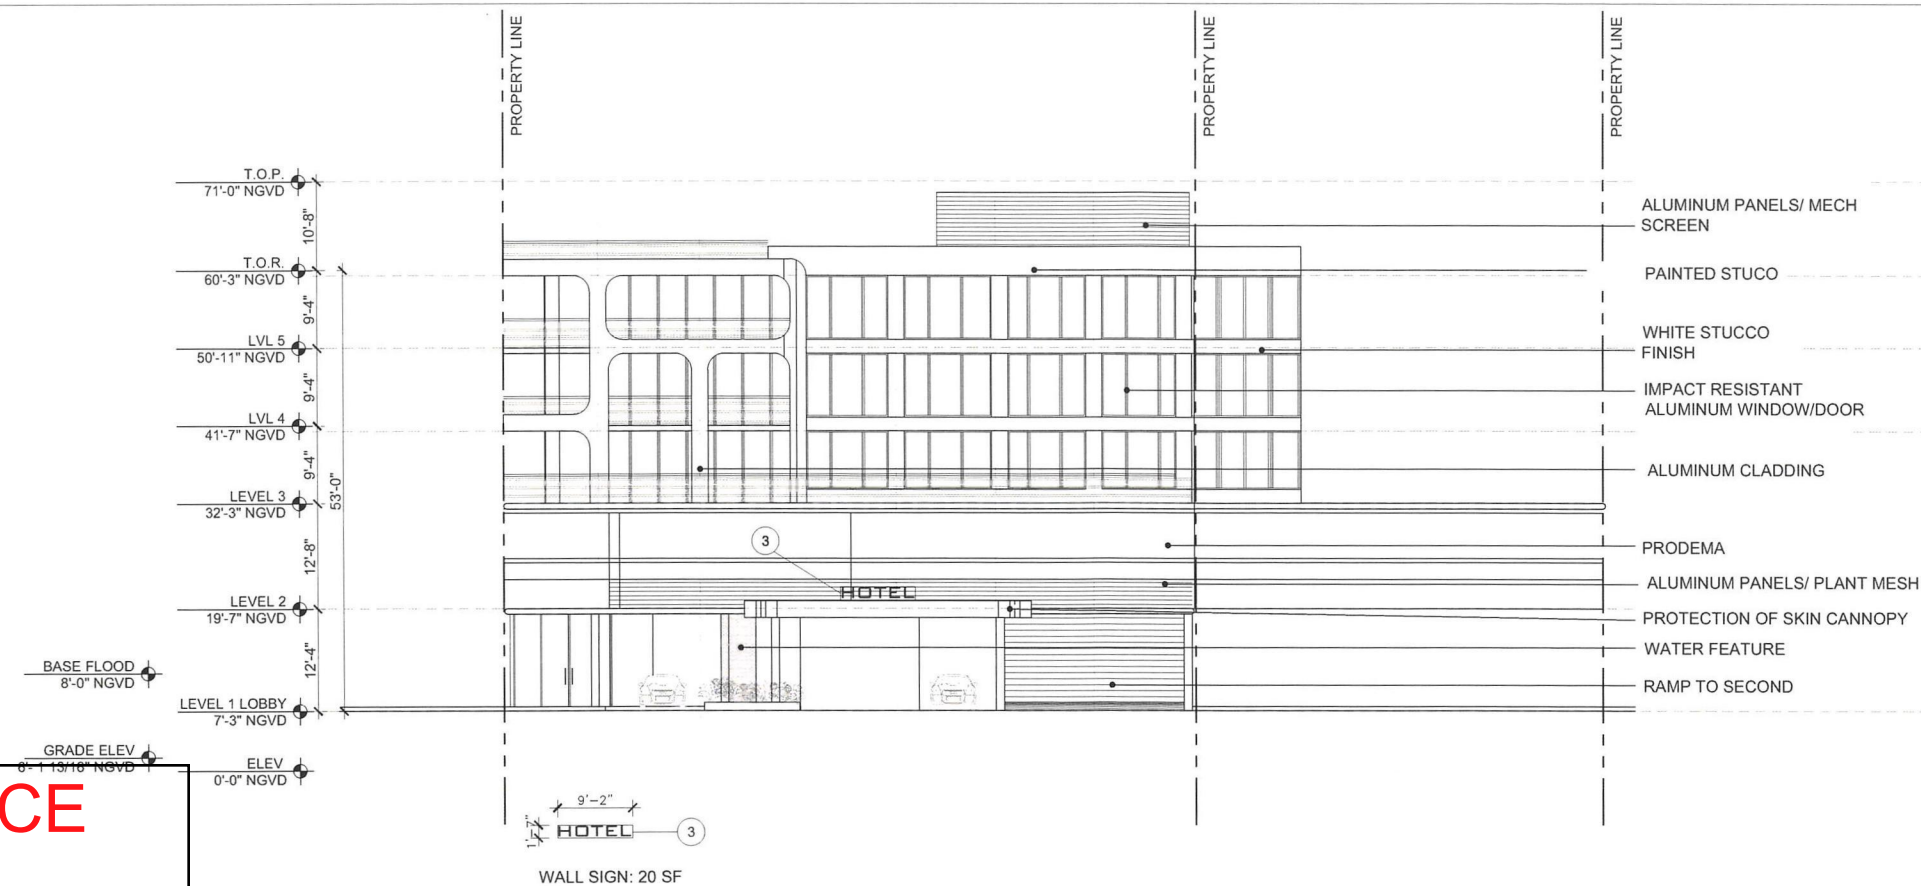

1 WEST ELEVATION
Scale: 3/32"=1'-0"

REVISIONS / SUBMISSIONS	
1	
2	
3	
4	
5	
6	
7	
8	
9	
10	
11	
12	

1384

ALL DRAWINGS AND WRITTEN MATERIAL APPEARING HEREIN
CONSTITUTE THE ORIGINAL AND UNPUBLISHED WORK OF KOB
KARP AIA, AND MAY NOT BE REPRODUCED, COPIED, OR DISCLOSED
WITHOUT THE EXPRESS WRITTEN CONSENT OF KOB KARP
ARCHITECTURE & INTERIOR DESIGN, INC. AIA REG. # 2012

1750 ALTON HOTEL


1750 ALTON ROAD
MIAMI BEACH, FLORIDA 33139

WEST ELEVATION



17
OCT 20 2015
Lic. # AR0012578

ARCHITECTURE
INTERIOR DESIGN
PLANNING
AIA ASID NCARB
2015 Biscayne Boulevard
Suite 200
Miami, FL 33137
O: 305.573.1818
F: 305.573.3766
WWW.KOBKARP.COM

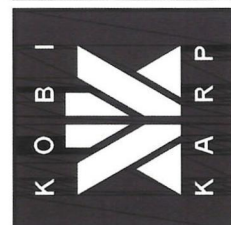

DRAWN BY:
CHECKED BY:
DATE: APRIL 2012

A4.03