 
 




NOTES:		LEGEND	
① - EXPOSED CONC SLAB, PAINT FINISH.	⑨ - ALL STORM AND SANITARY PIPES - VERTICALLY AND HORIZONTALLY - SHALL BE INSULATED (MIN. 1") INCLUDING THE ONES WITHIN DROPPED CEILINGS.	 - CEILING HEIGHTS INDICATED BY THIS SHADE ARE : LEVELS 3-5 - HOTEL 9'-0" A.C.S.	 RECESSED DOWNLIGHT
② - SMOOTH STUCCO, PAINT FINISH.	⑩ - ALL PERMETRAL PARTITIONS AND ALL ABOVE DOOR HEADERS DEFINING A PLENUM AREA, METAL STUDS AND INTERNAL DRYWALL LAYERS MUST BE ALLOWED TO THE THICKNESS OF THE CONCRETE SLAB.	 - CEILING HEIGHTS INDICATED BY THIS SHADE ARE : LEVELS 3-5 - HOTEL 8'-0" A.C.S.	 WALL MOUNTED LIGHT
③ - SMOOTH MONOCOTE, PAINT FINISH.	⑪ - NO COMBUSTIBLE MATERIALS SHOULD BE ALLOWED IN THE A/C PLENUM AREAS AND A/C CLOSETS. HOWEVER, WHERE APPROVED LIMITED COMBUSTIBLE MATERIALS ARE TO BE USED IN A/C PLENUM AREAS AND A/C CLOSETS, THESE MATERIALS SHALL BE TREATED WITH PLENUM APPROVED PRODUCTS IN ORDER TO ACHIEVE COMPLIANCE WITH THE FLAME SPREAD RATING NOT GREATER THAN 25 AND THE SMOKE DEVELOPED RATING NOT GREATER THAN 50.	 - OTHER CEILING HEIGHTS A.C.S.	 JUNCTION BOX
④ - SUSPENDED GYP. BD., PAINT FINISH.	⑫ - A/C PLENUM AREAS SHALL BE OF NON COMBUSTIBLE OR LIMITED COMBUSTIBLE MATERIALS, AND HAVE A FLAME SPREAD RATING NOT GREATER THAN 25 AND SMOKE DEVELOPED RATING NOT GREATER THAN 50.	 (UNLESS OTHERWISE NOTED) A.C.S. - ABOVE CONCRETE SLAB	 WALL MOUNTED "J" BOX
⑤ - FIRE SPRINKLER HEADS AND OTHER CEILING FEATURES (ACCESS DOORS, GRILLES, LIGHT FIXTURES, ETC.) ARE SHOWN ONLY FOR ALIGNMENT. FOR THEIR MECHANICAL CHARACTERISTICS (SIZES, QUANTITIES, TYPES, ETC.) REFER TO MECHANICAL AND ELECTRICAL DRAWINGS AND SPECIFICATIONS.		 - R-19 MIN. INSULATION BOARD AT CEILING	 A/C SUPPLY (CEILING MOUNT)
⑥ - GENERAL CONTRACTOR TO SUBMIT SHOP DRAWINGS FOR REVIEW BEFORE INSTALLATION. G.C. TO COORDINATE LOCATIONS AND COORDINATE WITH ALL TRADES PRIOR TO SUBMITAL.		 RECESSED WALL MOUNTED LIGHT	 A/C SUPPLY (WALL MOUNTED)
⑦ - FINISH CEILING HEIGHTS ARE GIVEN FROM TOP OF CONCRETE FLOOR SLAB (UNLESS OTHERWISE NOTED).			 A/C RETURN (WALL MOUNTED)
			 A/C RETURN GRILLE
			 SOFFIT LINE
			 HEADER
			 PLENUM AREA
			 1 HR. RATED WALL
			 2 HR. RATED WALL

.....

GENERAL HOTEL ROOM NOTES:

1. PROVIDE 3- $\frac{5}{8}$ " BATT INSULATION ALL SIDES OF PARTITIONS AT: BATHS, A/C CLOSETS AND BETWEEN HOTEL ROOMS.
2. DIMENSIONS TO ALL PLUMBING FIXTURES & APPLIANCES ARE FROM FACE OF GWB TO CENTERLINE OF FIXTURE.
3. SLIDING GLASS DOORS TO PROVIDE A 32" CLEAR OPENING TO BALCONY.
4. SLIDING GLASS DOORS ARE UNABLE TO COMPLY WITH THE FAIR HOUSING ACT THRESHOLD REQUIREMENT DUE TO REQ'D WATER DAM. WHEN NEED ARISES, A RAMP WILL BE PROVIDED.
5. PROVIDE MIN. R-5 INSULATION AT ALL CMU AND CONCRETE SHEARWALLS, EXTERIOR WALLS, AND A/C AREAS ADJACENT TO NON-A/C AREAS, TYP.
6. PROVIDE MIN. R-19 INSULATION AT ROOFS.

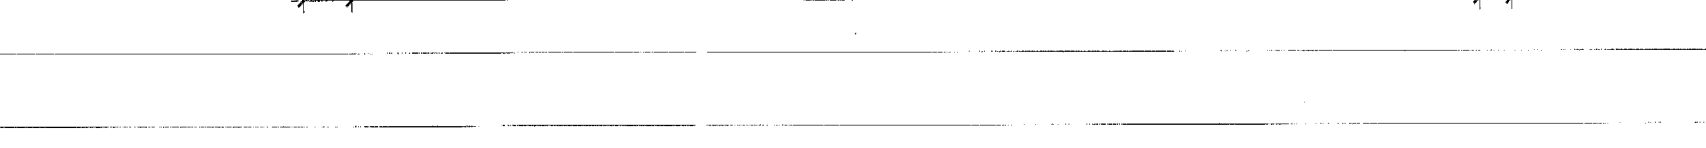


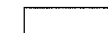NOTES:		LEGEND	
① - EXPOSED CONG. SLAB, PAINT FINISH.	⑨ - ALL STORM AND SANITARY PIPES - VERTICALLY AND HORIZONTALLY - SHALL BE INSULATED (MIN. 1"). INCLUDING THE ONES WITHIN DROPPED CEILINGS.	 - CEILING HEIGHTS INDICATED BY THIS SHADE ARE: LEVELS 3-5 - HOTEL	 RECESSED DOWNLIGHT
② - SMOOTH 1/2" STUCCO, PAINT FINISH.			 WALL MOUNTED LIGHT
③ - SMOOTH MONOCOTE, PAINT FINISH.	⑩ - ALL PERMETEAL PARTITIONS AND ALL ABOVE DOOR HEADERS DEFINING A PLENUM AREA, METAL STUDS AND INTERNAL DRYWALL LAYERS MUST EXTEND TO THE UNDERSIDE OF THE CONCRETE SLAB.		 JUNCTION BOX
④ - SUSPENDED 1/2" GYP. BD., PAINT FINISH.			 WALL MOUNTED "J" BOX
⑤ - FIRE SPRINKLER HEADS AND OTHER CEILING FEATURES (ACCESS DOORS, GRILLS, JET FIXTURES, ETC.) ARE SHOWN ONLY FOR ALIGNMENT. FOR THEIR MECHANICAL CHARACTERISTICS (SIZES, QUANTITY, TYPES, ETC.) REFER TO MECHANICAL AND ELECTRICAL DRAWINGS AND SPECIFICATIONS.	⑪ - NO COMBUSTIBLE MATERIALS SHOULD BE ALLOWED IN THE A/C PLENUM AREAS AND A/C CLOSETS. HOWEVER, WHERE APPROVED LIMITED COMBUSTIBLE MATERIALS ARE TO BE USED IN A/C PLENUM AREAS AND A/C CLOSETS, THESE MATERIALS SHALL BE PREPARED WITH PLENUM APPROVED PRODUCTS IN ORDER TO ACHIEVE COMPLIANCE WITH THE FLAME SPREAD RATING NOT GREATER THAN 25 AND THE SMOKE DEVELOPED RATING NOT GREATER THAN 50.	 - CEILING HEIGHTS INDICATED BY THIS SHADE ARE: LEVELS 3-5 - HOTEL	 A/C SUPPLY (CEILING MOUNTED)
		 (UNLESS OTHERWISE NOTED) A.C.S. = ABOVE CONCRETE SLAB	 A/C SUPPLY (WALL MOUNTED)
⑦ - GENERAL CONTRACTOR TO SUBMIT SHOP DRAWINGS FOR REVIEW BEFORE INSTALLATION. G.C. TO COORDINATE LOCATIONS AND COORDINATE WITH ALL TRADES PRIOR TO SUBMITTAL.	⑫ - A/C PLENUM AREAS SHALL BE OF NON-COMBUSTIBLE OR LIMITED COMBUSTIBLE MATERIALS, AND HAVE A FLAME SPREAD RATING NOT GREATER THAN 25 AND SMOKE DEVELOPED RATING NOT GREATER THAN 50.	 - OTHER CEILING HEIGHTS A.C.S.	 A/C RETURN (WALL MOUNTED)
⑧ - FINISH CEILING HEIGHTS ARE GIVEN FROM TOP OF CONCRETE FLOOR SLAB (UNLESS OTHERWISE NOTED).		 - R-19 MIN. INSULATION BOARD AT CEILING	 A/C RETURN GRILLE
		 RECESSED WALL MOUNTED LIGHT	 SOFFIT LINE
			 HEADER
			 PLENUM AREA
			 1 HR. RATED WALL
			 2 HR. RATED WALL



GENERAL HOTEL ROOM NOTES:

1. PROVIDE 3- $\frac{3}{8}$ " BATT INSULATION ALL SIDES OF PARTITIONS AT: BATHS, A/C CLOSETS AND BETWEEN HOTEL ROOMS.
2. DIMENSIONS TO ALL PLUMBING FIXTURES & APPLIANCES ARE FROM FACE OF GWB TO CENTERLINE OF FIXTURE.
3. SLIDING GLASS DOORS TO PROVIDE A 32" CLEAR OPENING TO BALCONY.
4. SLIDING GLASS DOORS ARE UNABLE TO COMPLY WITH THE FAIR HOUSING ACT THRESHOLD REQUIREMENT DUE TO REQ'D WATER DAM. WHEN NEED ARISES, A RAMP WILL BE PROVIDED.
5. PROVIDE MIN. R-5 INSULATION AT ALL CMU AND CONCRETE SHEARWALLS, EXTERIOR WALLS, AND A/C AREAS ADJACENT TO NON-A/C AREAS, TYP.
6. PROVIDE MIN. R-19 INSULATION AT ROOFS.

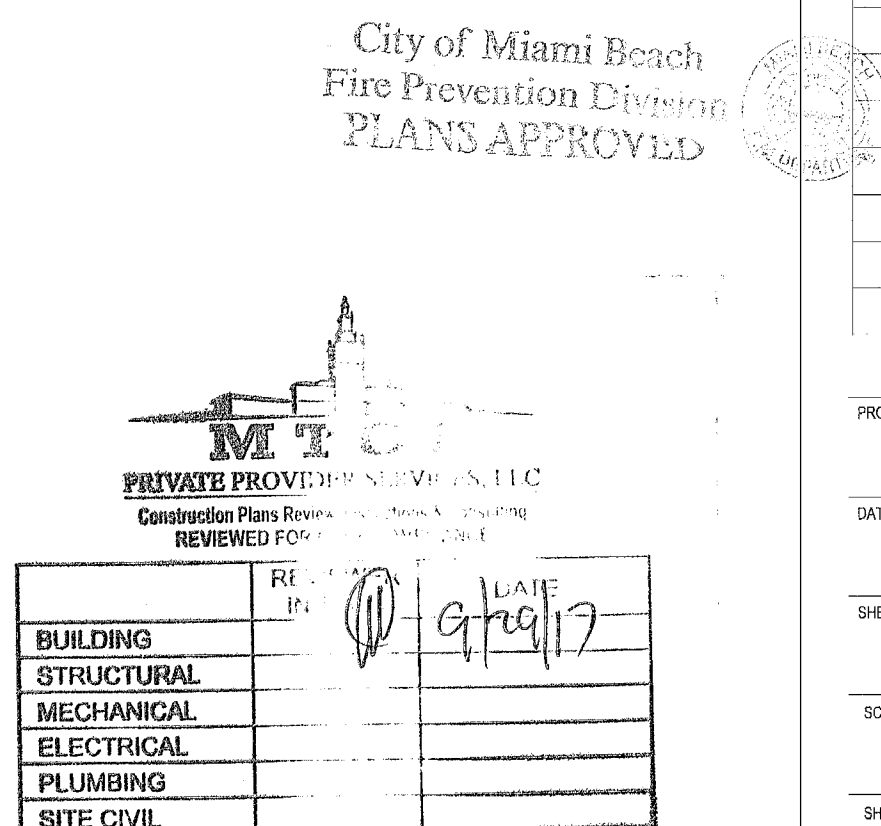

PERMUY
ARCHITECTURE
INTERIOR DESIGN
PLANNING
7 Ponce de Leon Blvd.
Coral Gables, FL, 33134
Phone : 305.200.5302
www.PermuyArchitecture.com

Relio Muly
07-28-17

THESE DESIGNS AND DRAWINGS ARE THE COPYRIGHTED PROPERTY OF PERMYU ARCHITECTURE. INTERIOR DESIGN, PLANNING, INC. AND MAY NOT BE REPRODUCED OR TRANSMITTED IN ANY FORM OR BY ANY MEANS, WITHOUT SPECIFICATION WRITTEN CONSENT OF THE ARCHITECT. THE CONTRACTOR MUST CHECK AND VERIFY DIMENSIONS OF THE JOB AND BE RESPONSIBLE FOR REPORTING ANY DISCREPANCIES TO THE ARCHITECT BEFORE COMMENCING WORK. DRAWINGS ARE NOT TO BE USED

PALOMAR
SOUTH BEACH
1750 Alton Road, Miami Beach, FL 33139
FINVARB GROUP

1065 Kane Concourse, Suite 201, Bay Harbor Island, FL 33154

[illegible]

PROJECT NO. 1613

DATE: 02.28.17

SHEET INDEX:

SCALE: As Noted

SHEET NO.


A-306

FOR ALL HOTEL ROOMS


GENERAL HOTEL ROOM NOTES:

1. PROVIDE 3-8" BATT INSULATION ALL SIDES OF PARTITIONS AT: BATHS, A/C CLOSETS AND BETWEEN HOTEL ROOMS.
2. DIMENSIONS TO ALL PLUMBING FIXTURES & APPLIANCES ARE FROM FACE OF GWB TO CENTERLINE OF FIXTURE.
3. SLIDING GLASS DOORS TO PROVIDE A 32" CLEAR OPENING TO BALCONY.
4. SLIDING GLASS DOORS ARE UNABLE TO COMPLY WITH THE FAIR HOUSING ACT THRESHOLD REQUIREMENT DUE TO REQ'D WATER DAM. WHEN NEED ARISES, A RAMP WILL BE PROVIDED.
5. PROVIDE MIN. R-5 INSULATION AT ALL CMU AND CONCRETE SHEARWALLS, EXTERIOR WALLS, AND A/C AREAS ADJACENT TO NON-A/C AREAS, TYP.
6. PROVIDE MIN. R-19 INSULATION AT ROOFS.

NOTES:		LEGEND	
1	EXPOSED CONG. SLAB, PAINT FINISH.	1	CEILING HEIGHTS INDICATED BY THIS SHADE ARE: LEVELS 3-5 = HOTEL
2	SMOOTH STUCCO, PAINT FINISH.	2	RECESSED DOWNLIGHT
3	SMOOTH MONOTE, PAINT FINISH.	3	WALL MOUNTED LIGHT
4	SUSPENDED GYP. BD., PAINT FINISH.	4	JUNCTION BOX
5	FIRE SPRINKLER HEADS AND OTHER CEILING FEATURES (ACCESS DOORS, GRIFFS, LIGHT FIXTURES, ETC.) ARE SHOWN ONLY FOR ALIGNMENT. FOR THEIR MECHANICAL CHARACTERISTICS (SIZES, QUANTITY, TYPES, ETC.) REFER TO MECHANICAL AND ELECTRICAL DRAWINGS AND SPECIFICATIONS.	5	WALL MOUNTED "J" BOX
6	GENERAL CONTRACTOR TO SUBMIT SHOP DRAWINGS FOR REVIEW BEFORE INSTALLATION. CO TO COORDINATE LOCATIONS AND COORDINATE WITH TRADES PRIOR TO SUBMITTAL.	6	A/C SUPPLY (CEILING MOUNTED)
7	FINISH CEILING HEIGHTS ARE GIVEN FROM TOP OF CONCRETE FLOOR SLAB (UNLESS OTHERWISE NOTED).	7	A/C SUPPLY (WALL MOUNTED)
		8	A/C RETURN (WALL MOUNTED)
		9	A/C RETURN GRILLE
		10	SOFTLY LINE HEADS
		11	PLENUM AREA
		12	1 HR. RATED WALL
		13	2 HR. RATED WALL

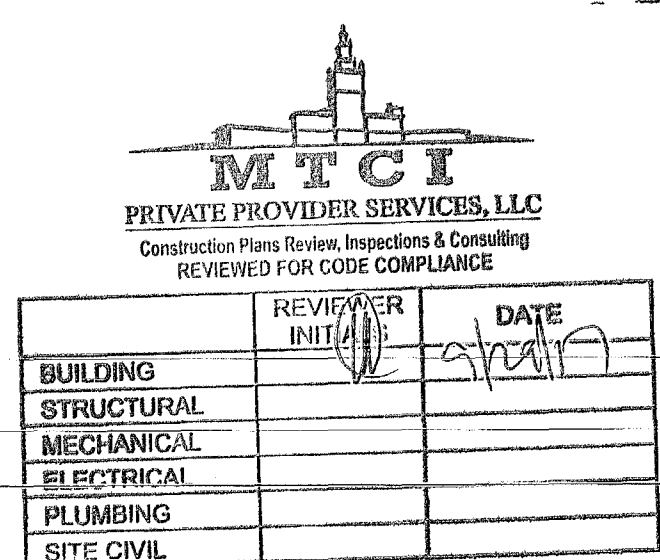

SCALE: 1/2" = 1'-0"

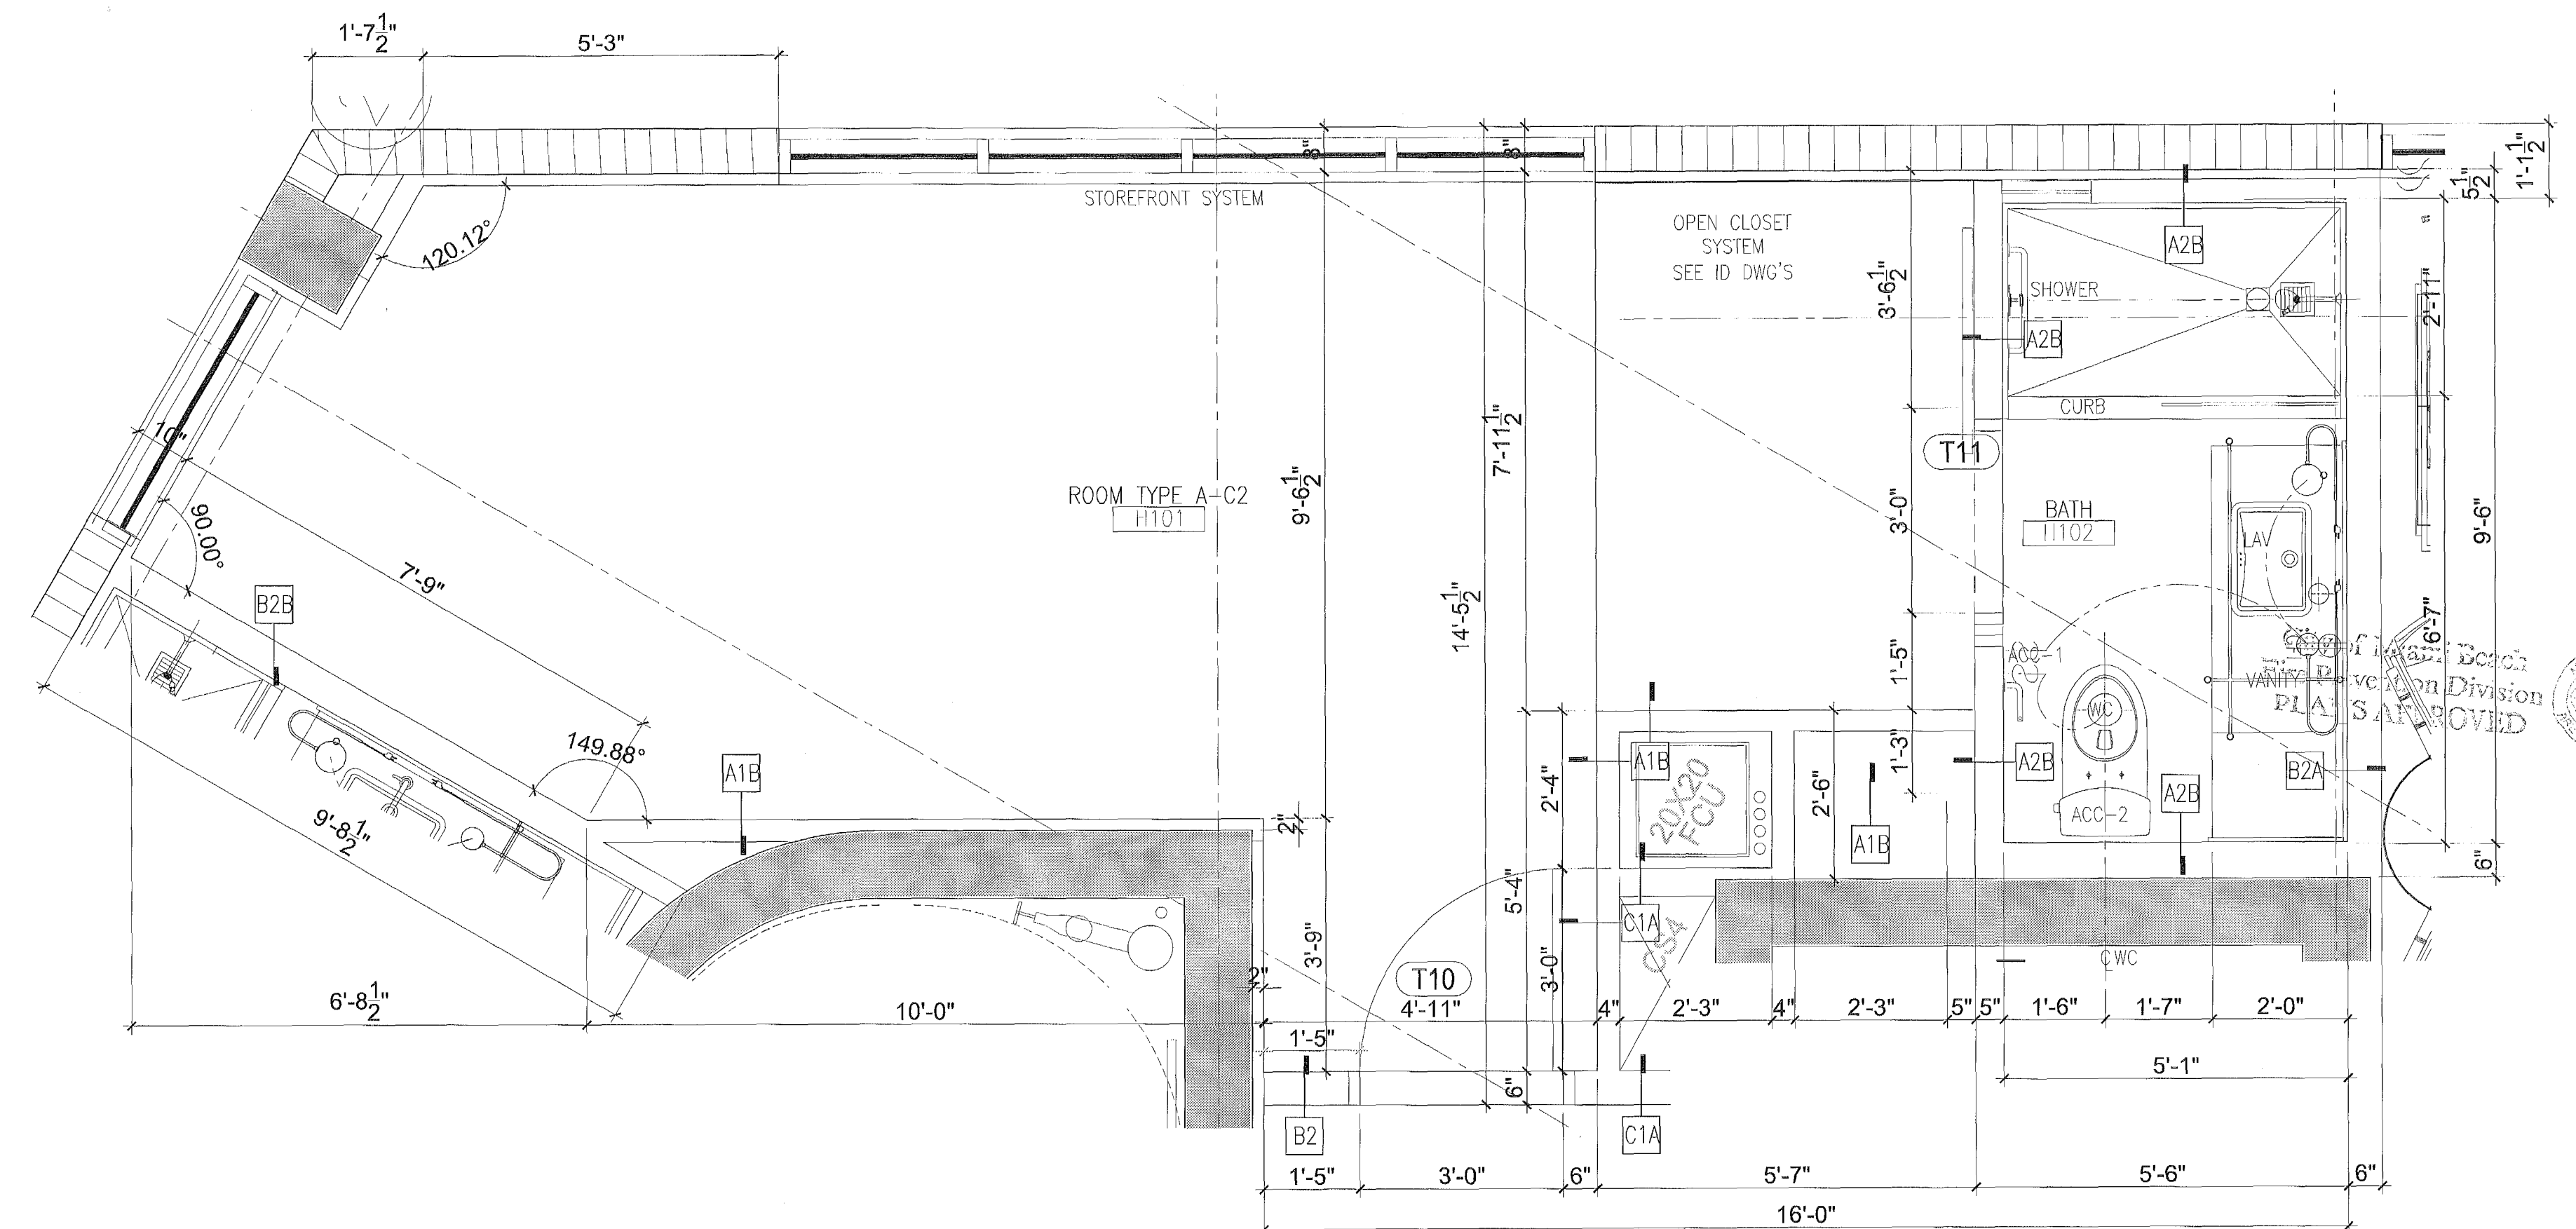

SCALE: 1/2" = 1'-0"

PROJECT NO.

1613

DATE:

02.28.17

SHEET INDEX:

SCALE:

As Noted


SHEET NO.

NOTES:		LEGEND:	
① - EXPOSED CONG. SLAB, PAINT FINISH.	⑨ - ALL STORM AND SANITARY PIPES - VERTICALLY AND HORIZONTALLY- SHALL BE INSULATED (MIN. 1"), INCLUDING THE ONES WITH DROPPED CEILINGS.	 - CEILING HEIGHTS INDICATED BY THIS SHADE ARE : LEVELS 3-5 - HOTEL	 RECESSED DOWNLIGHT
② - SMOOTH 3/8" STUCCO, PAINT FINISH.	⑩ - ALL PERIMETRAL PARTITIONS AND ALL ABOVE DOOR HEADERS DEFINING A PLENUM AREA, METAL STUDS AND INTERNAL DRYWALL LAYERS MUST EXTEND TO THE UNDERSIDE OF THE CONCRETE SLAB.	 - CEILING HEIGHTS INDICATED BY THIS SHADE ARE : LEVELS 3-5 - HOTEL	 WALL MOUNTED LIGHT
③ - SMOOTH MONOCOTE, PAINT FINISH.	⑪ - NO COMBUSTIBLE MATERIALS SHOULD BE ALLOWED IN A/C PLENUM AREAS AND A/C CLOSETS. HOWEVER, WHEN APPROVED LIMITED COMBUSTIBLE MATERIALS ARE TO BE USED IN A/C PLENUM AREAS AND A/C CLOSETS, THESE MATERIALS SHALL BE TREATED WITH PLENUM APPROVED PRODUCTS IN ORDER TO ACHIEVE COMPLIANCE WITH THE FLAME SPREAD RATING NOT GREATER THAN 25 AND THE SMOKE DEVELOPED RATING NOT GREATER THAN 50.	 - CEILING HEIGHTS INDICATED BY THIS SHADE ARE : LEVELS 3-5 - HOTEL	 JUNCTION BOX
④ - SUSPENDED 3/8" GYP. BD., PAINT FINISH.	⑫ - A/C PLENUM AREAS SHALL BE OF NON COMBUSTIBLE OR LIMITED COMBUSTIBLE MATERIALS, AND HAVE A FLAME SPREAD RATING NOT GREATER THAN 25 AND SMOKE DEVELOPED RATING NOT GREATER THAN 50.	 - CEILING HEIGHTS INDICATED BY THIS SHADE ARE : LEVELS 3-5 - HOTEL	 WALL MOUNTED 3/8" BOX
⑤ - FIRE SPRINKLER HEADS AND OTHER CEILING FEATURES (ACCESS DOORS, GRILLS, LIGHT FIXTURES, ETC.), ARE SHOWN ONLY FOR ALIGNMENT. FOR THEIR THERMOCAL CHARACTERISTICS (SIZES, QUANTITY, TYPES, ETC.) REFER TO MECHANICAL AND ELECTRICAL DRAWINGS AND SPECIFICATIONS.		 - CEILING HEIGHTS INDICATED BY THIS SHADE ARE : LEVELS 3-5 - HOTEL	 A/C SUPPLY (CEILING MOUNTED)
⑥ - GENERAL CONTRACTOR TO SUBMIT SHOP DRAWINGS FOR REVIEW BEFORE INSTALLATION, G.C. TO COORDINATE LOCATIONS AND COORDINATE WITH ALL TRADES PRIOR TO SUBMITTAL.		 - CEILING HEIGHTS INDICATED BY THIS SHADE ARE : LEVELS 3-5 - HOTEL	 A/C RETURN (WALL MOUNTED)
⑦ - FINISH CEILING HEIGHTS ARE GIVEN FROM TOP OF CONCRETE FLOOR SLAB (UNLESS OTHERWISE NOTED).		 - CEILING HEIGHTS INDICATED BY THIS SHADE ARE : LEVELS 3-5 - HOTEL	 A/C RETURN GRILLE
		 - CEILING HEIGHTS INDICATED BY THIS SHADE ARE : LEVELS 3-5 - HOTEL	 SOFFIT LINE
		 - CEILING HEIGHTS INDICATED BY THIS SHADE ARE : LEVELS 3-5 - HOTEL	 HEADER
		 - CEILING HEIGHTS INDICATED BY THIS SHADE ARE : LEVELS 3-5 - HOTEL	 PLENUM AREA
		 - CEILING HEIGHTS INDICATED BY THIS SHADE ARE : LEVELS 3-5 - HOTEL	 1 HR. RATED WALL
		 - CEILING HEIGHTS INDICATED BY THIS SHADE ARE : LEVELS 3-5 - HOTEL	 2 HR. RATED WALL



A1	UNIT A-C4 PLAN
----	----------------

ADA ACCESSORIES LEGEND	
(A)	FOLD DOWN SHOWER SEAT, MTD 18" AFF TO TOP OF SEAT, REFER TO FIG 610.3 AT A-035 FOR LAYOUT.
(B)	GRAB BAR MTD. 34" AFF TO TOP OF BAR, 12" LONG
(C)	GRAB BAR MTD. 34" AFF TO TOP OF BAR, 24" LONG
(D)	GRAB BAR MTD. 34" AFF TO TOP OF BAR, 36" LONG
(E)	GRAB BAR MTD. 34" AFF TO TOP OF BAR, 42" LONG
(F)	SHOWER CONTROLS
(G)	LAVATORY, MTD 34" AFF WITH MIN. 29" CLEARANCE KNEE SPACE

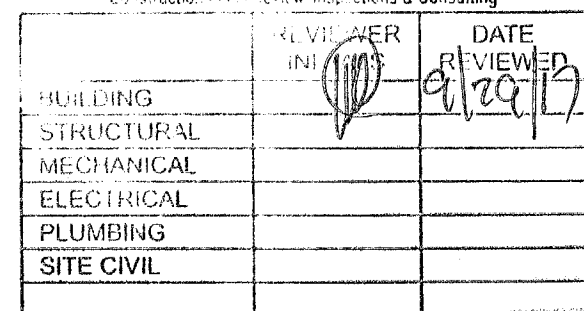

A-310

Adrian M. Permy
1.2.2.18

STATE OF FLORIDA
REGISTERED ARCHITECT
REGISTRATION #680004953

THESE DESIGNS AND DRAWINGS ARE THE
COPYRIGHTED PROPERTY OF PERMUY
ARCHITECTURE, INTERIOR DESIGN AND
PLANNING, INC. AND MAY NOT BE REPRODUCED
EXCEPT WITH SPECIFIC WRITTEN
CONSENT OF THE ARCHITECT. THE
CONTRACTOR MUST CHECK AND VERIFY ALL
DIMENSIONS OF THE JOB AND BE RESPONSIBLE
FOR SAME. REPORTING ANY DISCREPANCIES TO
THE ARCHITECT BEFORE COMMENCING WORK.
DRAWINGS ARE NOT TO BE SCALED


KIMTOWN HOTEL
PALOMAR
SOUTH BEACH
1750 Alton Road, Miami Beach, FL 33139

FINVARB GROUP
1085 Kane Concourse, Suite 201, Bay Harbor Island, FL 33154

PROJECT	DATE
NO.	DESCRIPTION
1	PERMIT SET
2	REV. 2
3	REV. 4

NO.	DESCRIPTION	DATE
1	PERMIT SET	02.28.17
2	REV. 2	05.31.17
3	REV. 4	11.22.17

PROJECT NO.
1613
DATE
11.22.17
SHEET INDEX
SCALE
As Noted
SHEET NO.
A-401

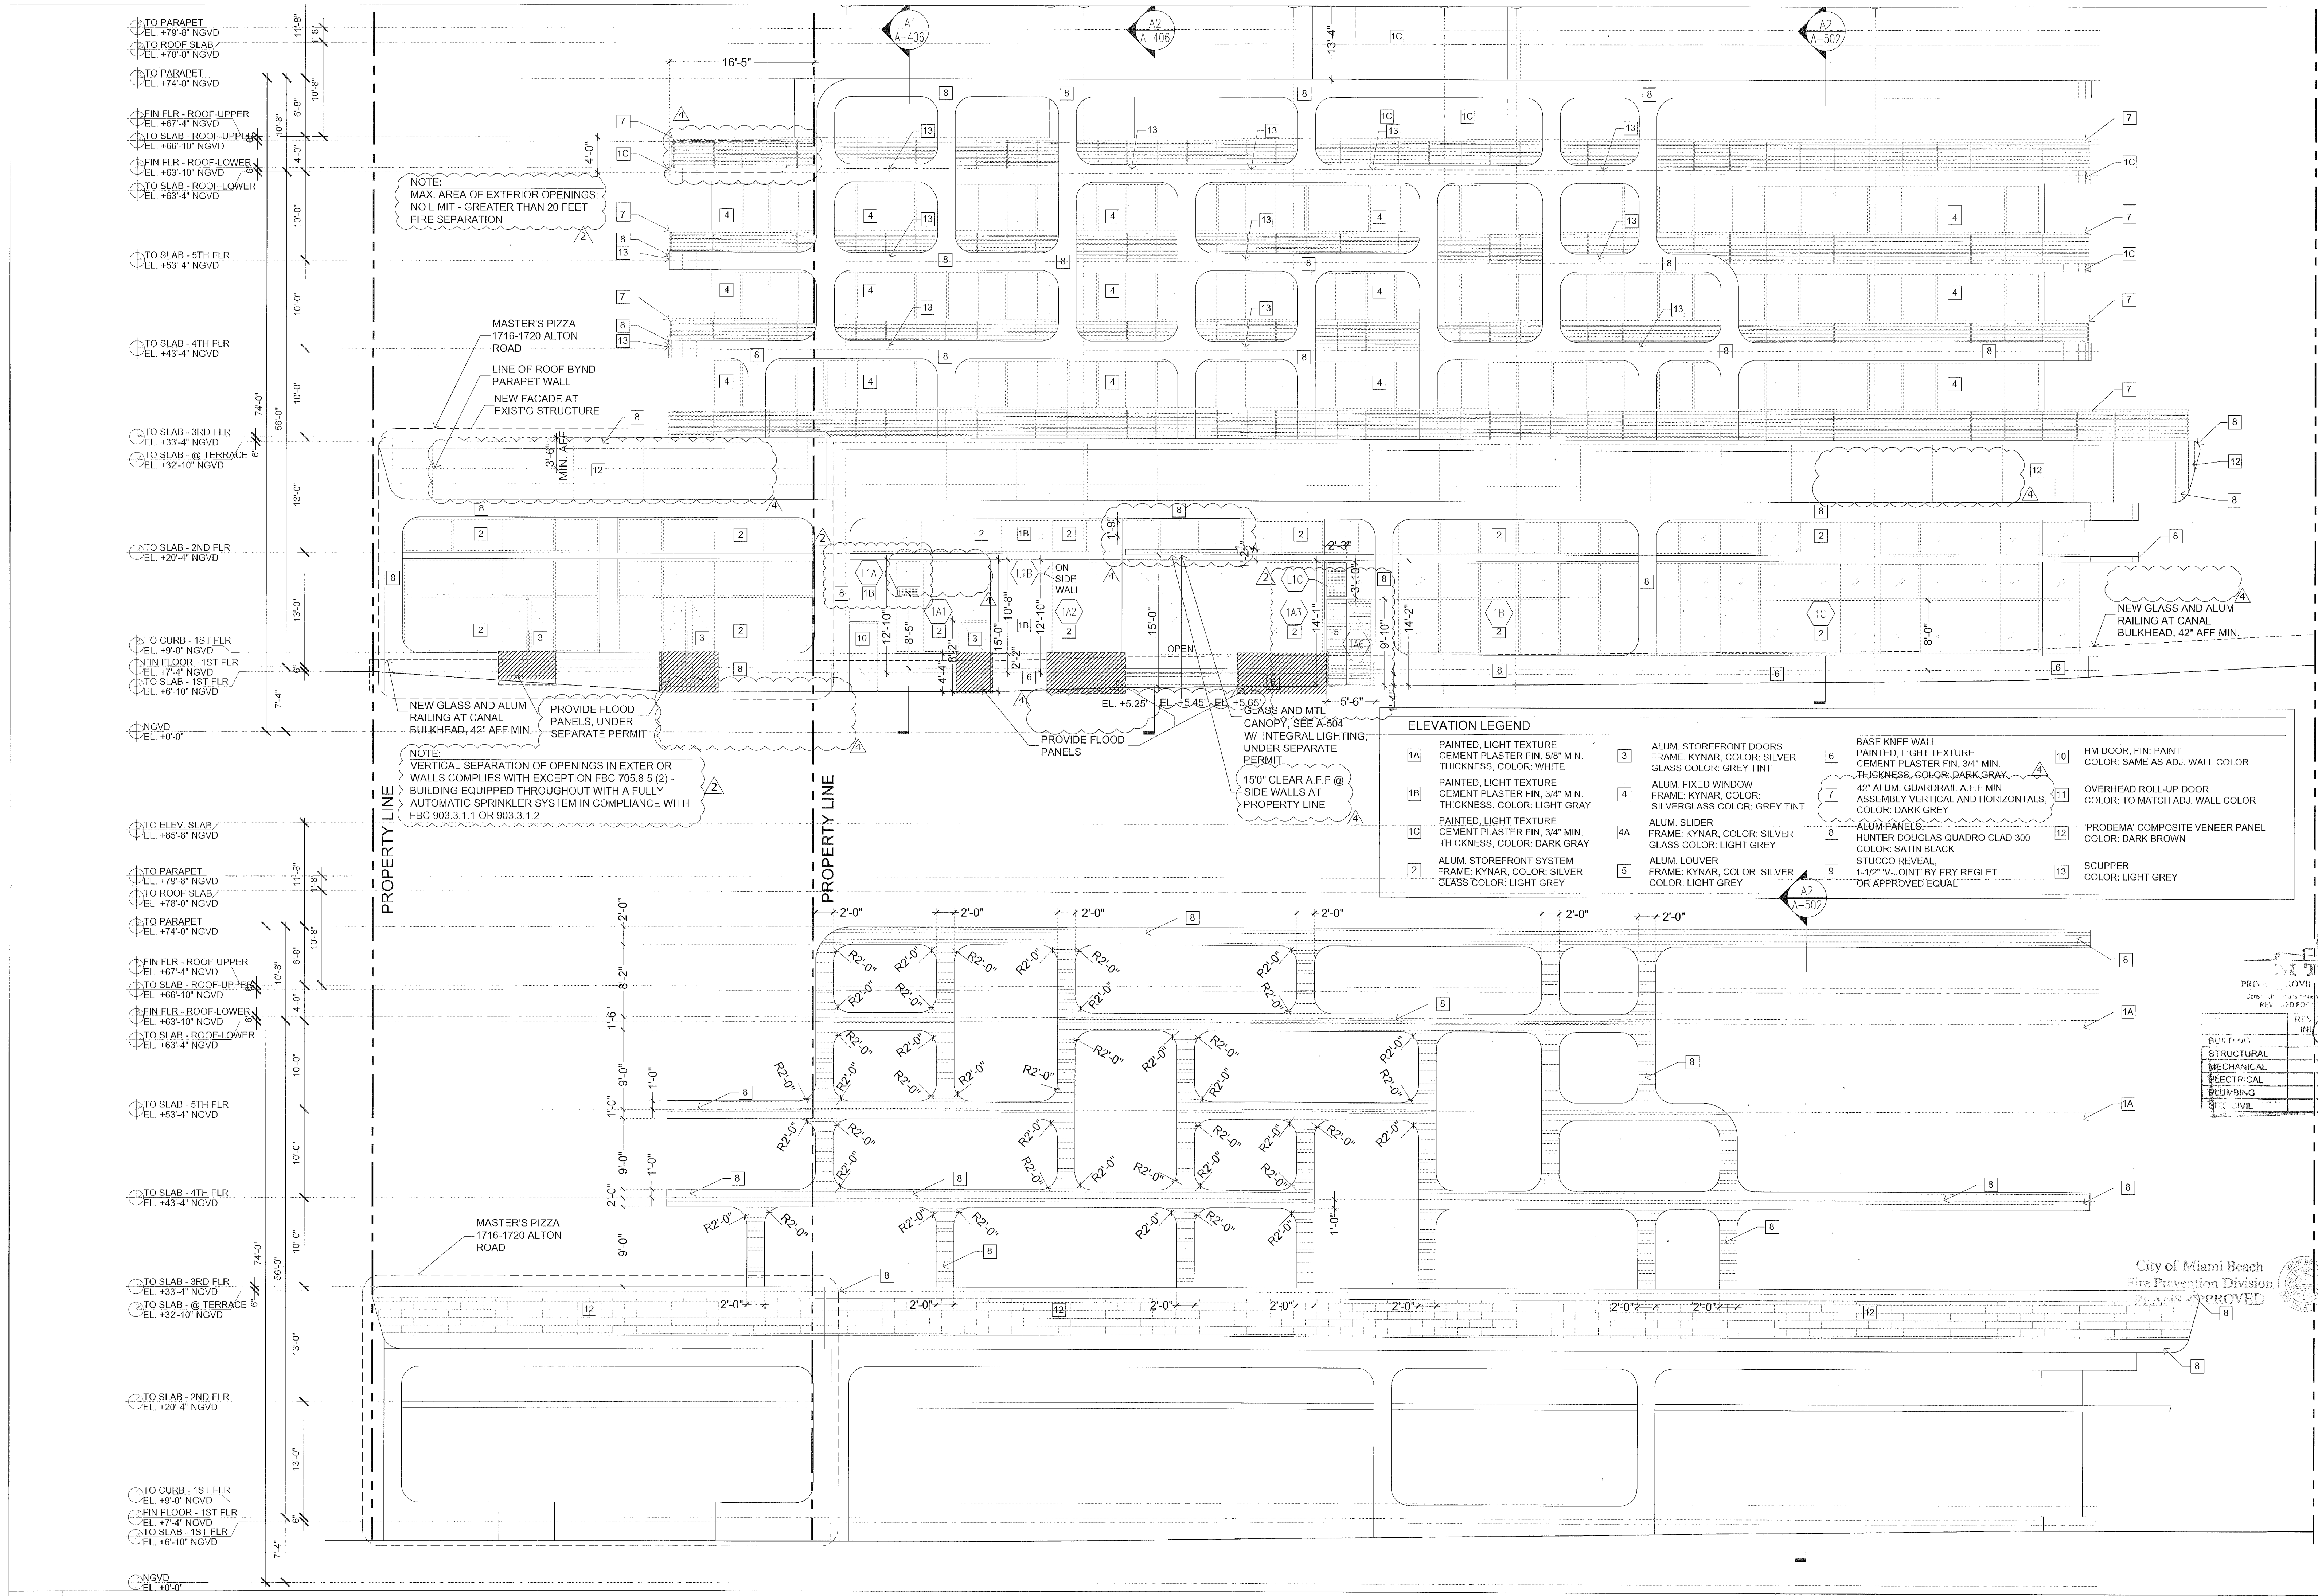

A1 EAST ELEVATION
SCALE: 1/8" = 1'-0"

1-2-18

STATE OF FLORIDA
REGISTERED ARCHITECT
REGISTRATION #A0000953

THESE DESIGNS AND DRAWINGS ARE THE
COPYRIGHTED PROPERTY OF PERMUY
ARCHITECTURE, INTERIOR DESIGN AND
PLANNING, INC. AND MAY NOT BE REPRODUCED
EXCEPT WITH SPECIFICATION WRITTEN
CONSENT OF THE ARCHITECT.
CONTRACTOR MUST CHECK AND VERIFY ALL
DIMENSIONS OF THE JOB AND BE RESPONSIBLE
FOR SAME. REPORTING ANY DISCREPANCIES TO
THE ARCHITECT BEFORE COMMENCING WORK.
DRAWINGS ARE NOT TO BE SCALED

1750 Alton Road, Miami Beach, FL 33139
FINVARG GROUP
1005 Kane Concourse, Suite 201, Bay Harbor Island, FL 33154


SPECIALTY ENG. TO SUBMIT
SHOP DWGS FOR ENGINEER
AND ARCHITECT APPROVAL

NOTE:
MAX. AREA OF EXTERIOR OPENINGS:
NO LIMIT - GREATER THAN 20 FEET
FIRE SEPARATION

NOTE:
VERTICAL SEPARATION OF OPENINGS IN EXTERIOR
WALLS COMPLIES WITH EXCEPTION FBC 705.8.5 (2) -
BUILDING EQUIPPED THROUGHOUT WITH A FULLY
AUTOMATIC SPRINKLER SYSTEM IN COMPLIANCE WITH
FBC 903.3.1.1 OR 903.3.1.2

ELEVATION LEGEND


- | | | | | | | | |
|----|---|----|---|---|--|----|--|
| 1A | PAINTED, LIGHT TEXTURE
CEMENT PLASTER FIN, 5/8" MIN.
THICKNESS, COLOR: WHITE | 3 | ALUM. STOREFRONT DOORS
FRAME: KYNAR, COLOR: SILVER
GLASS COLOR: GREY TINT | 6 | BASE KNEE WALL
PAINTED, LIGHT TEXTURE
CEMENT PLASTER FIN, 3/4" MIN.
THICKNESS, COLOR: DARK GRAY | 10 | HM DOOR, FIN: PAINT
COLOR: SAME AS ADJ. WALL COLOR |
| 1B | PAINTED, LIGHT TEXTURE
CEMENT PLASTER FIN, 3/4" MIN.
THICKNESS, COLOR: LIGHT GRAY | 4 | ALUM. FIXED WINDOW
FRAME: KYNAR, COLOR:
SILVERGLASS COLOR: GREY TINT | 7 | ALUM. GUARDRAIL ASSEMBLY
VERTICAL AND HORIZONTALS,
COLOR: DARK GREY | 11 | OVERHEAD ROLL-UP DOOR
COLOR: TO MATCH ADJ. WALL COLOR |
| 1C | PAINTED, LIGHT TEXTURE
CEMENT PLASTER FIN, 3/4" MIN.
THICKNESS, COLOR: DARK GRAY | 4A | ALUM. SLIDER
FRAME: KYNAR, COLOR: SILVER
GLASS COLOR: LIGHT GREY | 8 | ALUM. PANELS,
HUNTER DOUGLAS QUADRO CLAD 300
COLOR: SATIN BLACK
STUCCO REVEAL,
1-1/2" V-JOINT BY FRY REGLET
OR APPROVED EQUAL | 12 | "PRODEMA" COMPOSITE VENEER PANEL
COLOR: DARK BROWN |
| 2 | ALUM. STOREFRONT SYSTEM
FRAME: KYNAR, COLOR: SILVER
GLASS COLOR: LIGHT GREY | 5 | ALUM. LOUVER
FRAME: KYNAR, COLOR: SILVER
COLOR: LIGHT GREY | 9 | | 13 | SCUPPER
COLOR: LIGHT GREY |

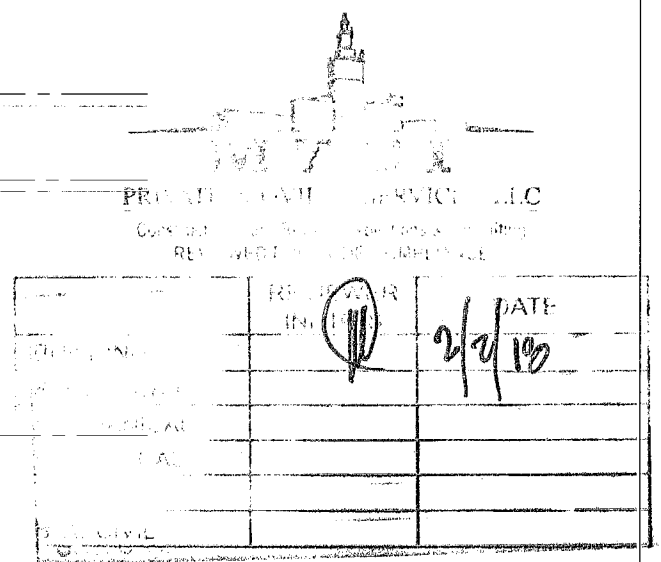


City of Miami Beach
Fire Prevention Division
PLANS APPROVED

No.	DESCRIPTION	DATE
1	PERMIT SET	02.28.17
2	REV. 2	05.31.17
4	REV. 4	11.22.17

PROJECT NO. 1613
DATE: 02.28.17
SHEET INDEX:
SCALE: As Noted
SHEET NO.

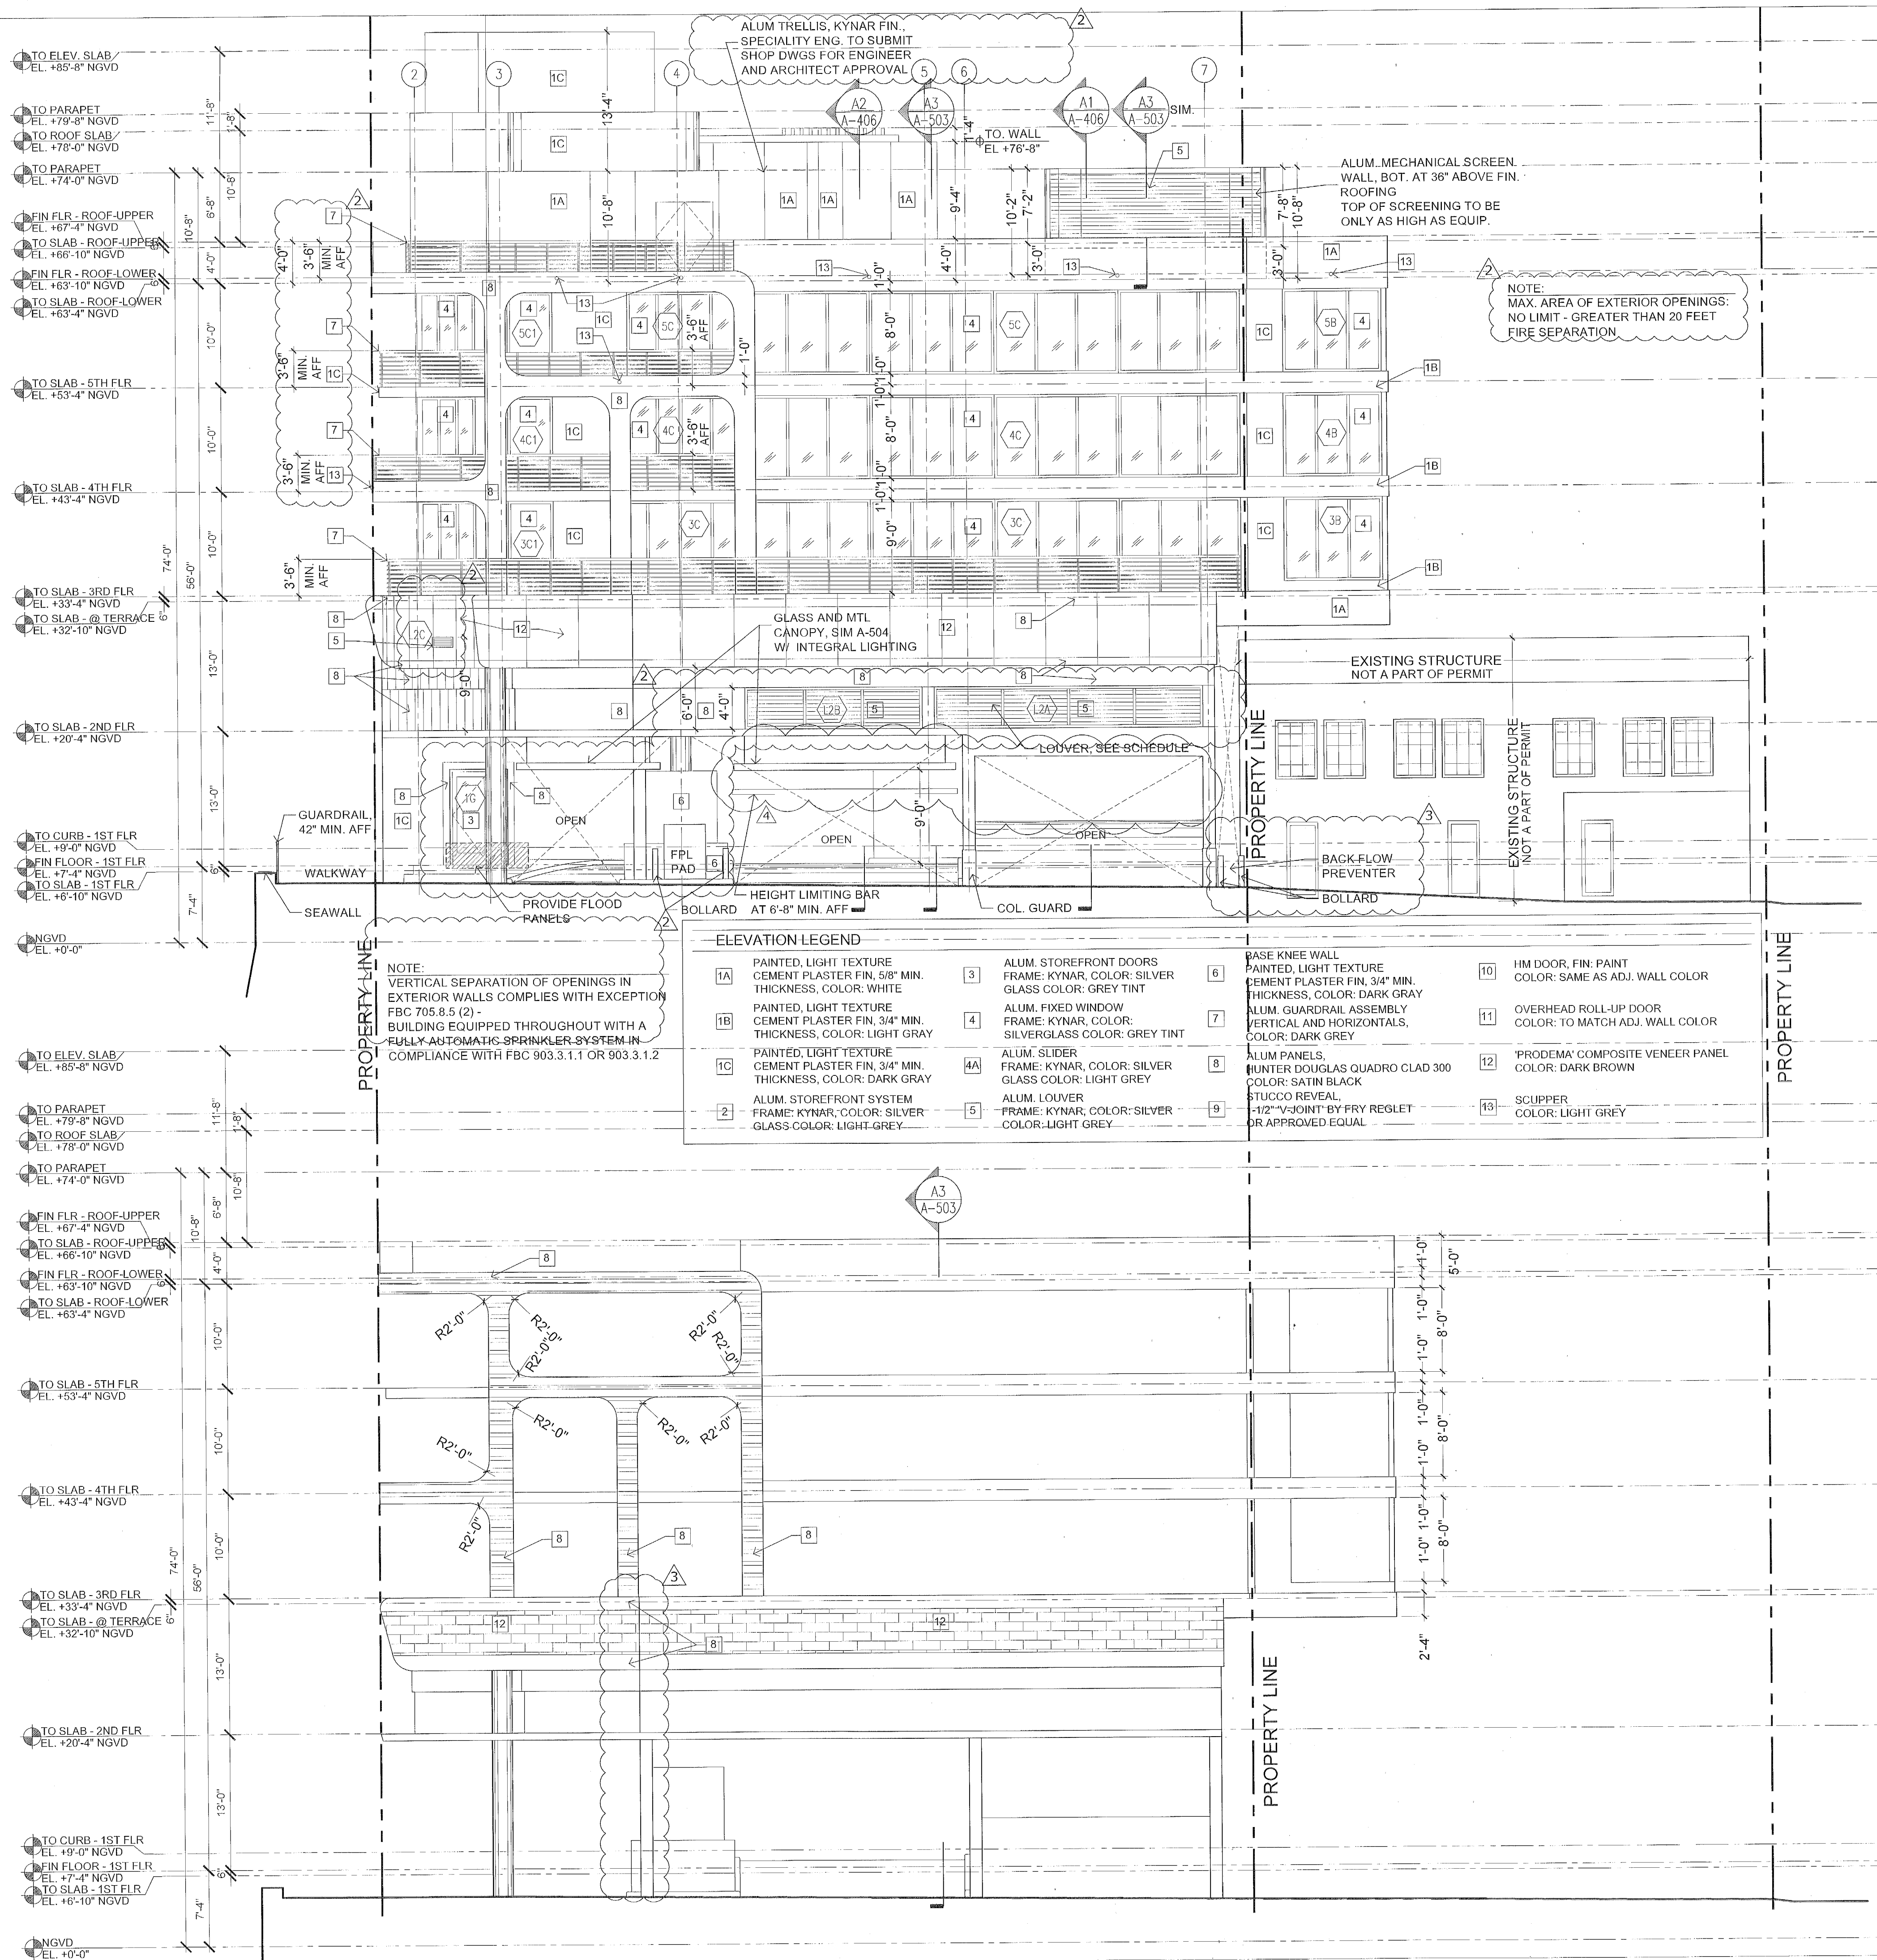

ELEVATION LEGEND							
1A	PAINTED, LIGHT TEXTURE CEMENT PLASTER FIN, 5/8" MIN. THICKNESS, COLOR: WHITE	3	ALUM. STOREFRONT DOORS FRAME: KYNAR, COLOR: SILVER GLASS COLOR: GREY TINT	6	BASE KNEE WALL PAINTED, LIGHT TEXTURE CEMENT PLASTER FIN, 3/4" MIN. THICKNESS, COLOR: DARK GRAY	10	HM DOOR, FIN: PAINT COLOR: SAME AS ADJ. WALL COLOR
1B	PAINTED, LIGHT TEXTURE CEMENT PLASTER FIN, 3/4" MIN. THICKNESS, COLOR: LIGHT GRAY	4	ALUM. FIXED WINDOW FRAME: KYNAR, COLOR: SILVERGLASS COLOR: GREY TINT	7	ALUM. GUARDRAIL ASSEMBLY VERTICAL AND HORIZONTALS, COLOR: DARK GREY	11	OVERHEAD ROLL-UP DOOR COLOR: TO MATCH ADJ. WALL COLOR
1C	PAINTED, LIGHT TEXTURE CEMENT PLASTER FIN, 3/4" MIN. THICKNESS, COLOR: DARK GRAY	4A	ALUM. SLIDER FRAME: KYNAR, COLOR: SILVER GLASS COLOR: LIGHT GREY	8	ALUM. PANELS, HUNTER DOUGLAS QUADRO CLAD 300 COLOR: SATIN BLACK STUCCO REVEAL	12	'PRODEMA' COMPOSITE VENEER PANEL COLOR: DARK BROWN
2	ALUM. STOREFRONT SYSTEM FRAME: KYNAR, COLOR: SILVER GLASS COLOR: LIGHT GREY	5	ALUM. LOUVER FRAME: KYNAR, COLOR: SILVER COLOR: LIGHT GREY	9	1/2" V-JOINT BY FRY REGLET OR APPROVED EQUAL	13	SCUPPER COLOR: LIGHT GREY

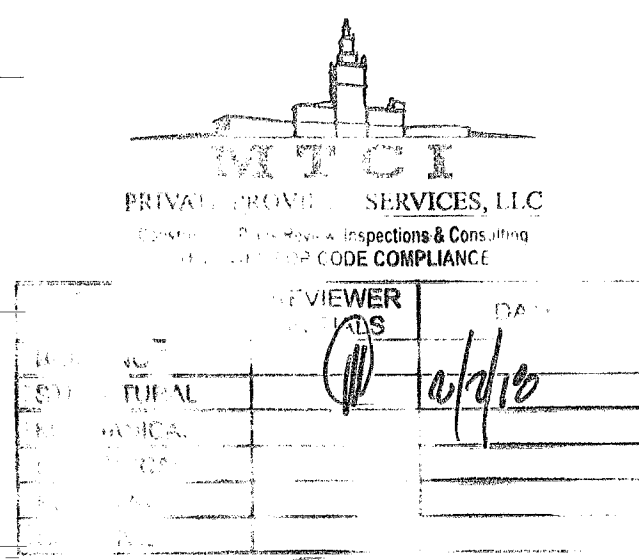

1460 Miles

STATE OF FLORIDA
HELIO MILIAN ARCHITECT
REGISTRATION #AR0206453

THESE DESIGNS AND DRAWINGS ARE THE COPYRIGHTED PROPERTY OF PERMYN ARCHITECTURE. INTERIOR DESIGN AND PLANNING, INC. AND MAY NOT BE REPRODUCED EXCEPT WITH SPECIFICATION WRITTEN CONSENT OF THE ARCHITECT. THE CONTRACTOR MUST CHECK AND VERIFY ALL DIMENSIONS OF THE JOB AND BE RESPONSIBLE FOR SAME. REPORTING ANY DISCREPANCIES TO THE ARCHITECT BEFORE COMMENCING WORK. DRAWINGS ARE NOT TO BE REPRODUCED.

KIMPTON HOTEL
PALOMAR
SOUTH BEACH
750 Alton Road, Miami Beach, FL 33139

FINVARB GROUP
065 Kane Concourse, Suite 201, Bay Harbor Island, FL 33154

[illegible]

PROJECT NO. 1613


DATE: 02.28.17

SHEET INDEX

SCALE: As Noted

SHEET NO.

A-404

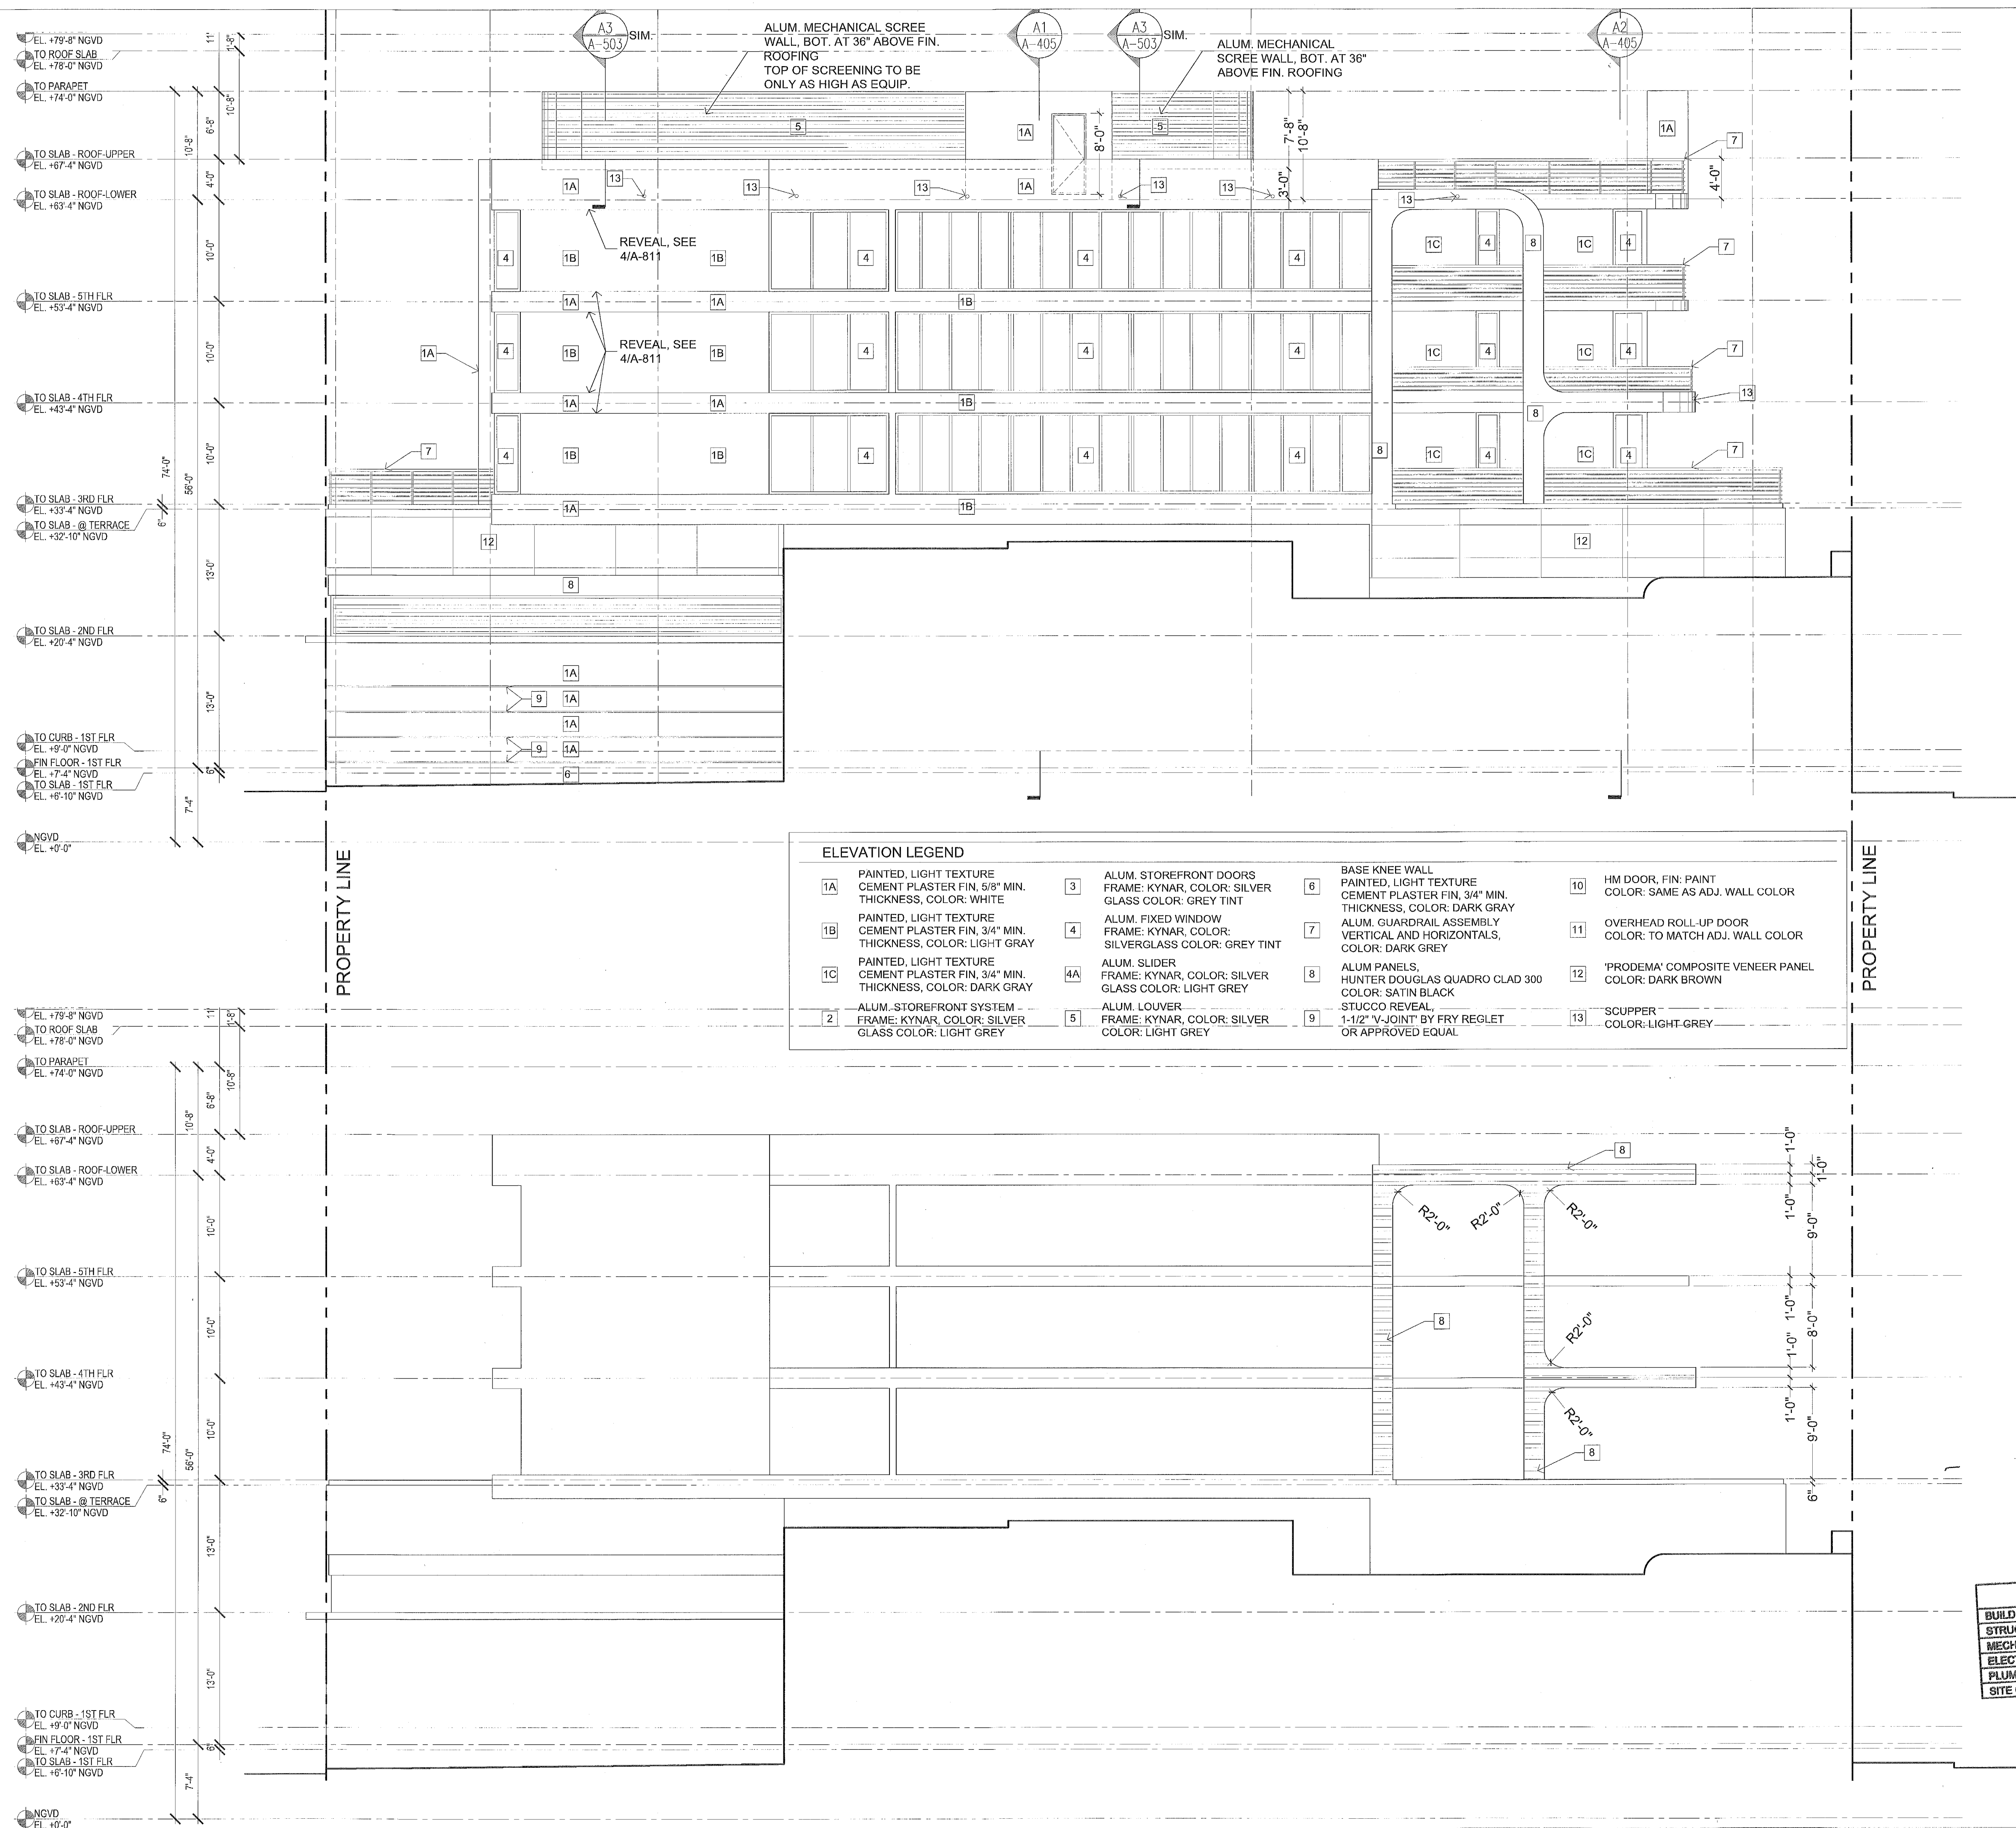


SCALE: 1/8" = 1'-0"

[illegible]

5/16/17

0271
b9 notia

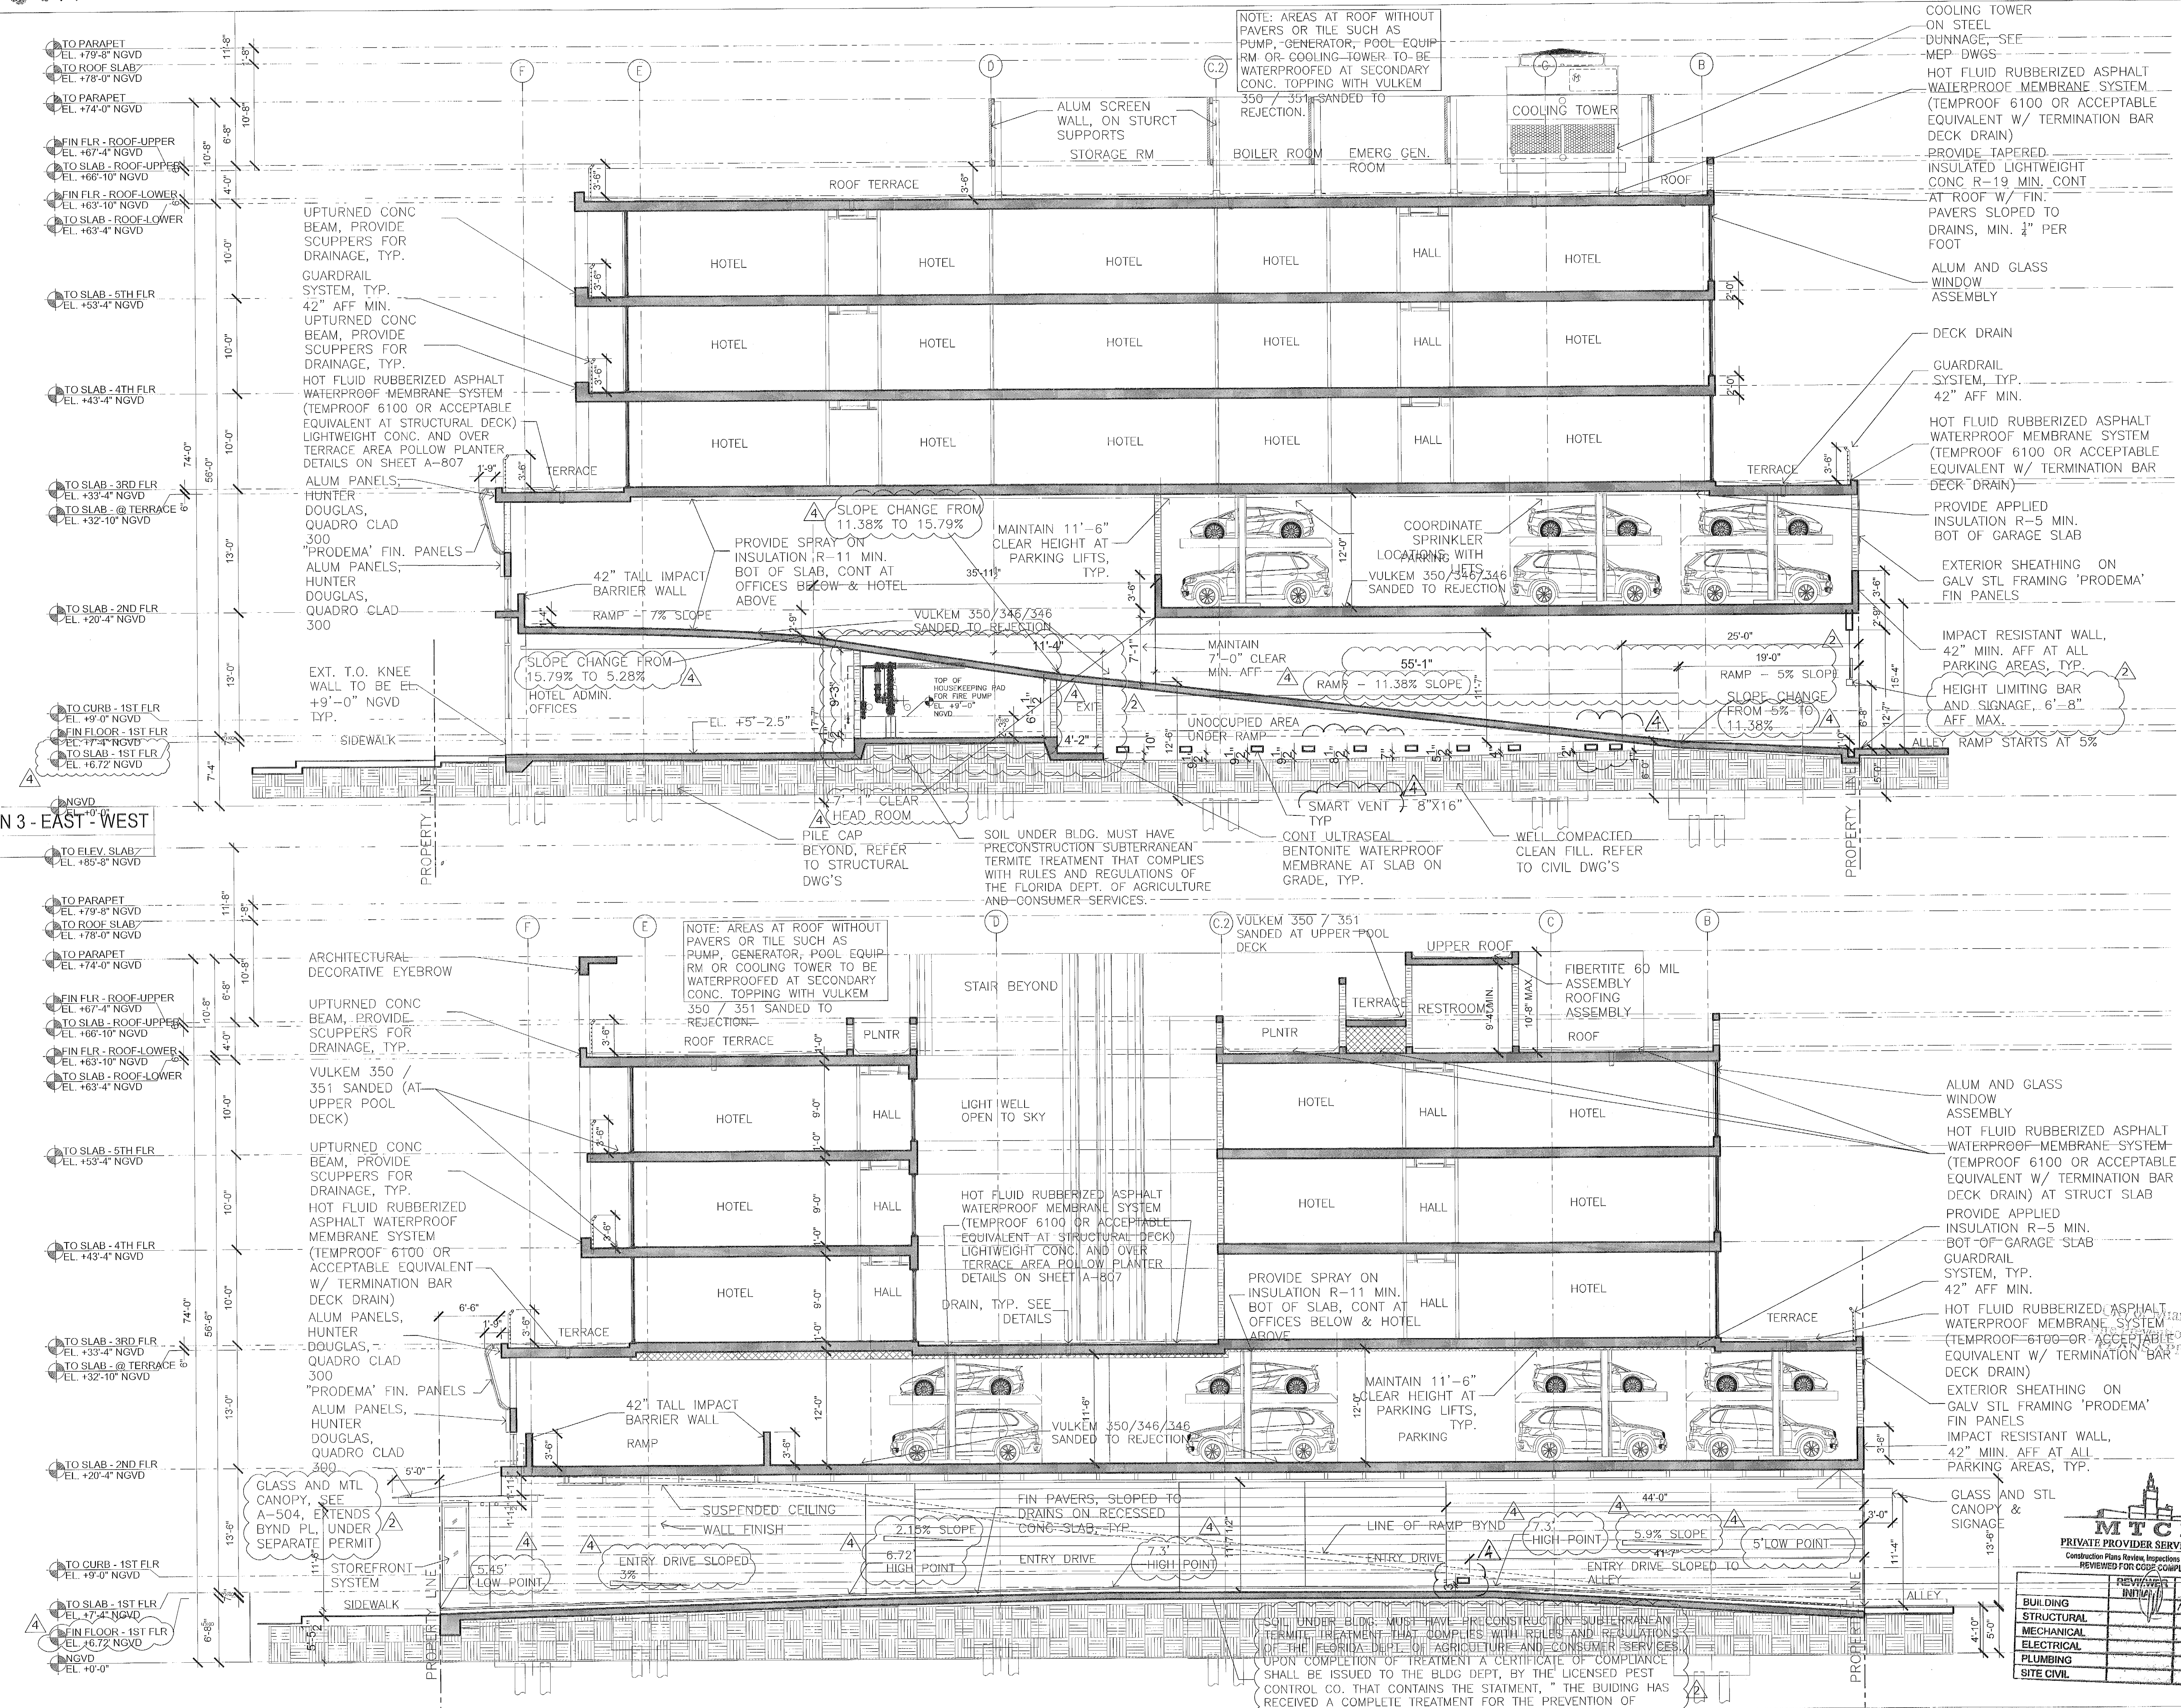

A1 BUILDING SECTION 3 - EAST - WEST

SCALE: 1/8" = 1'-0"

A2 BUILDING SECTION 4 - EAST - WEST

SCALE: 1/8" = 1'-0"

2717 Ponce de Leon Blvd.
Coral Gables, FL 33134
Phone : 305.200.5302
www.PermuyArchitecture.com

John Miller
2.2.18

STATE OF FLORIDA
HEIDI MILAN ARCHITECT
REGISTRATION #A00004953

THESE DESIGNS AND DRAWINGS ARE THE
COPYRIGHTED PROPERTY OF PERMUY
ARCHITECTURE INTERIOR DESIGN AND
PLANNING, INC. AND MAY NOT BE REPRODUCED
EXCEPT WITH SPECIFIC WRITTEN
CONSENT OF THE ARCHITECT. THE
CONTRACTOR MUST CHECK AND VERIFY ALL
DIMENSIONS OF THE JOB AND BE RESPONSIBLE
FOR SAME. REPORTING ANY DISCREPANCIES TO
THE ARCHITECT BEFORE COMMENCING WORK.
DRAWINGS ARE NOT TO BE SCALED

PALOMAR
KIMPTON HOTEL
SOUTH BEACH
1750 Alton Road, Miami Beach, FL 33139
FINVARB GROUP
1085 Kane Concourse, Suite 201, Bay Harbor Island, FL 33154

No.	DESCRIPTION	DATE
1	PERMIT SET	02.28.17
2	REV. 2	05.31.17
3	REV. 4	11.22.17

PROJECT NO.	1613
DATE:	02.28.17
SHEET INDEX:	
SCALE:	As Noted
SHEET NO.	

MTCI
PRIVATE PROVIDER SERVICES, LLC
Construction Plans Review, Inspections & Consulting
REVIEWED FOR CODE COMPLIANCE

REVIEWED	DATE
BUILDING	2/2/18
STRUCTURAL	
MECHANICAL	
ELECTRICAL	
PLUMBING	
SITE CIVIL	



MTCI
PRIVATE PROVIDER SERVICES, LLC
Construction, Plant Design, Inspection, Testing & Consulting




1750
Alton Rd

Palomar


Set: 2 of 2

[illegible]

REFER TO INTERIOR DESIGN DRAWINGS FOR CAB, JAMES, DOOR,
AND PLATE SELECTION AND FINISHES.

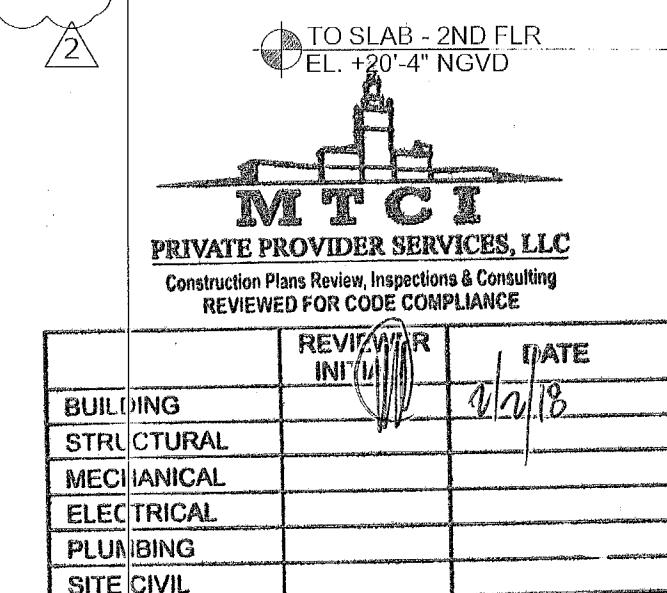

SCALE: 1/4" = 1'-0"

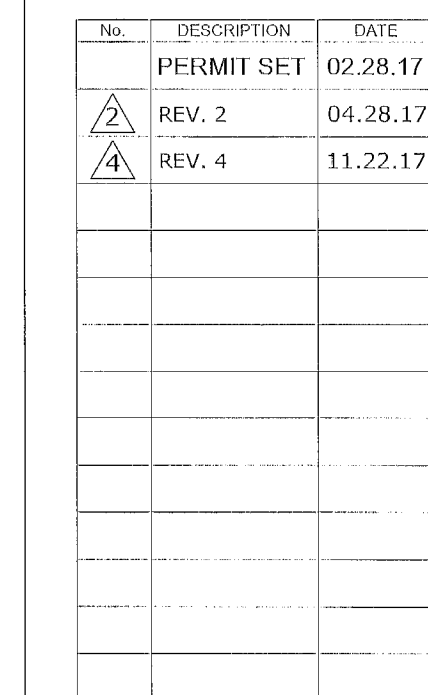

SHEET NO.

1. CHUTE TO BE FABRICATED OF 16-GA TYPE: AL/STL 24" DIAMETER.
2. WILKINSON 180 DEGREE OPENING STAINLESS STEEL CLAD, SIDE HINGED, HAND OPERATED, U.L. APPROVED 90 MIN., B-LABEL INTAKE DOOR W/ 250 DEG. MAXIMUM TEMPERATURE RISE IN 30. MIN.
3. DISCHARGE DOOR WILKINSON TYPE-H WITH 165 DEG F. FUSIBLE LINK. TOP HINGED, STAINLESS STEEL CLAD, U.L. APPROVED 90 MIN., B-LABEL DOOR ASSEMBLY W/ 250 DEG. MAXIMUM TEMPERATURE RISE IN 30. MIN.
4. FULL DIAMETER VENT WITH FLASHING AND METAL BAND. FABRICATED OF 16-GA TYPE: STAINLESS WITH CURB FLASHING.
5. 3/4"IPS FLUSHING SPRAY HEAD LOCATED IN CHANNEL.
6. TYPICAL CHUTE SUPPORT - 4 3"x2" CLIPS WELDED TO CHUTE TUBE SUPPORTING EACH STORY OF CHUTE HEIGHT FROM STRUCTURAL FRAME. FABRICATED OF 1-1/2"x1-1/2"x3/16" ANGLES AND 1-1/2"x3/16" BAR STOCK, WELDED ASSEMBLY
7. INTERMEDIATE 1/2"IPS - 185 DEGREE FUSIBLE LINKED AUTOMATIC SPRINKLERS.
8. PROVIDE DISINFECTING AND SANITIZING UNIT. PROVIDE ACCESS DOOR WITH FIRE RESISTANCE RATING EQUAL TO THAT OF TYPICAL INTAKE DOOR.
9. CYLINDER LOCKS PROVIDED WITH KEYS ALIKE CYLINDERS. LOCKS LOCATED AT EACH INTAKE DOOR WITH (4) KEYS PER LOCK.

NOTE:
REFER TO FIRE PROTECTION
DRAWINGS FOR SPRINKLER
PIPING & HEAD LOCATION.

NOTE:
COAT ENTIRE CHUTE
W/ VIBRATION DAMPING
COMPOUND

8" CMU
WALL

NOTE:
SUPPORT ANGLE FRAME
AT 4 SIDES TO SLAB ON (4)
SUPPORTS (S) ANCHORED
TO SLAB (SEE SPECS)

TRASH CHUTE

8" OF

4" SHAFT WALL W/ BATT INSULATION

STEEL STIFFENER
AT HEAD

WILKINSON 180 DEGREE OPENING
STAINLESS STEEL CLAD, SIDE HINGED,
HAND OPERATED, U.L. APPROVED 90
MIN., B-LABEL INTAKE DOOR W/ 250 DEG.
MAXIMUM TEMPERATURE RISE IN 30. MIN.

PIANO HINGE

1" THICK SOUND COAT
CARBAM AT HOPPER
NECK, BOTTOM & SIDES.

2' 4 1/4"

SLAB OPENING

1' 10 3/4"

1' 10 3/4"

1' 10 3/4"

2' 0"

1' 4"

Diagram illustrating a typical floor support assembly for a chute. The assembly includes a floor support (typ.) with 4 3"x2" clips welded to a chute tube supporting each story of chute height from the structural frame. The chute tube is supported by a 24" typical chute diameter with 165 DEG F. fusible link. The assembly is shown with a Wilkenson Type-H discharge door with 165 DEG F. fusible link, top hinged, stainless steel clad, U.L. approved 90 min., B-label door assembly w/ 250 DEG maximum temperature rise in 30 min.




SCALE: 1/4" = 1'-0"

A-408


No.	DESCRIPTION	DATE
	PERMIT SET	02.28.17
1	REV 4.	11.22.17

PROJECT NO.	1613
DATE:	02.28.17
SHEET INDEX:	
SCALE:	As Noted
SHEET NO.	

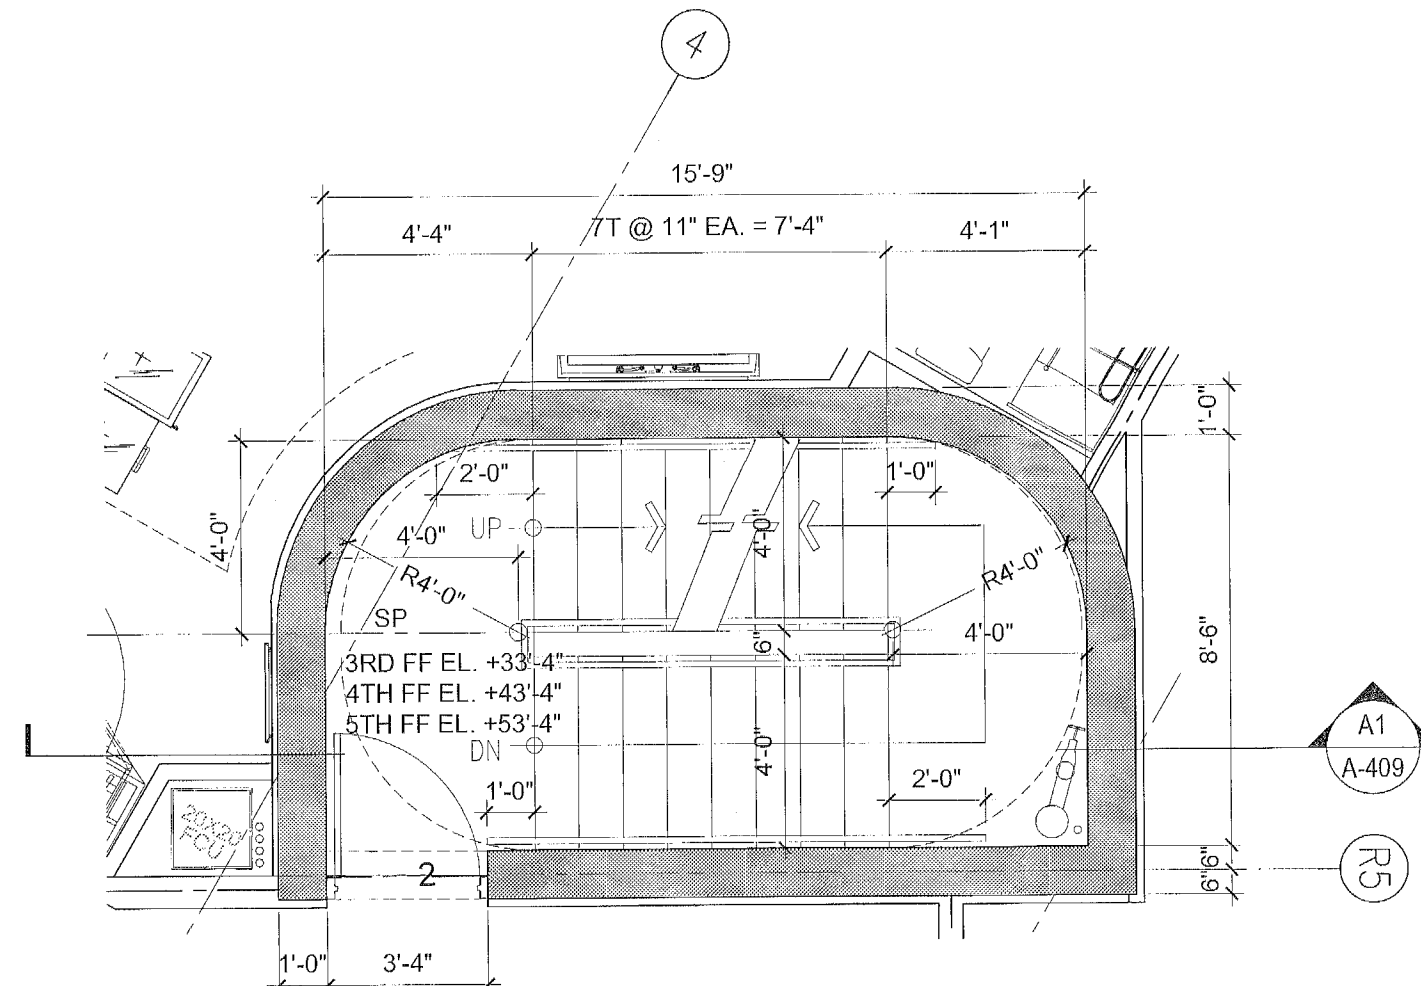


A4 STAIR #1 PLAN - 3-5TH FLOOR

SCALE: 1/4" = 1'-0"

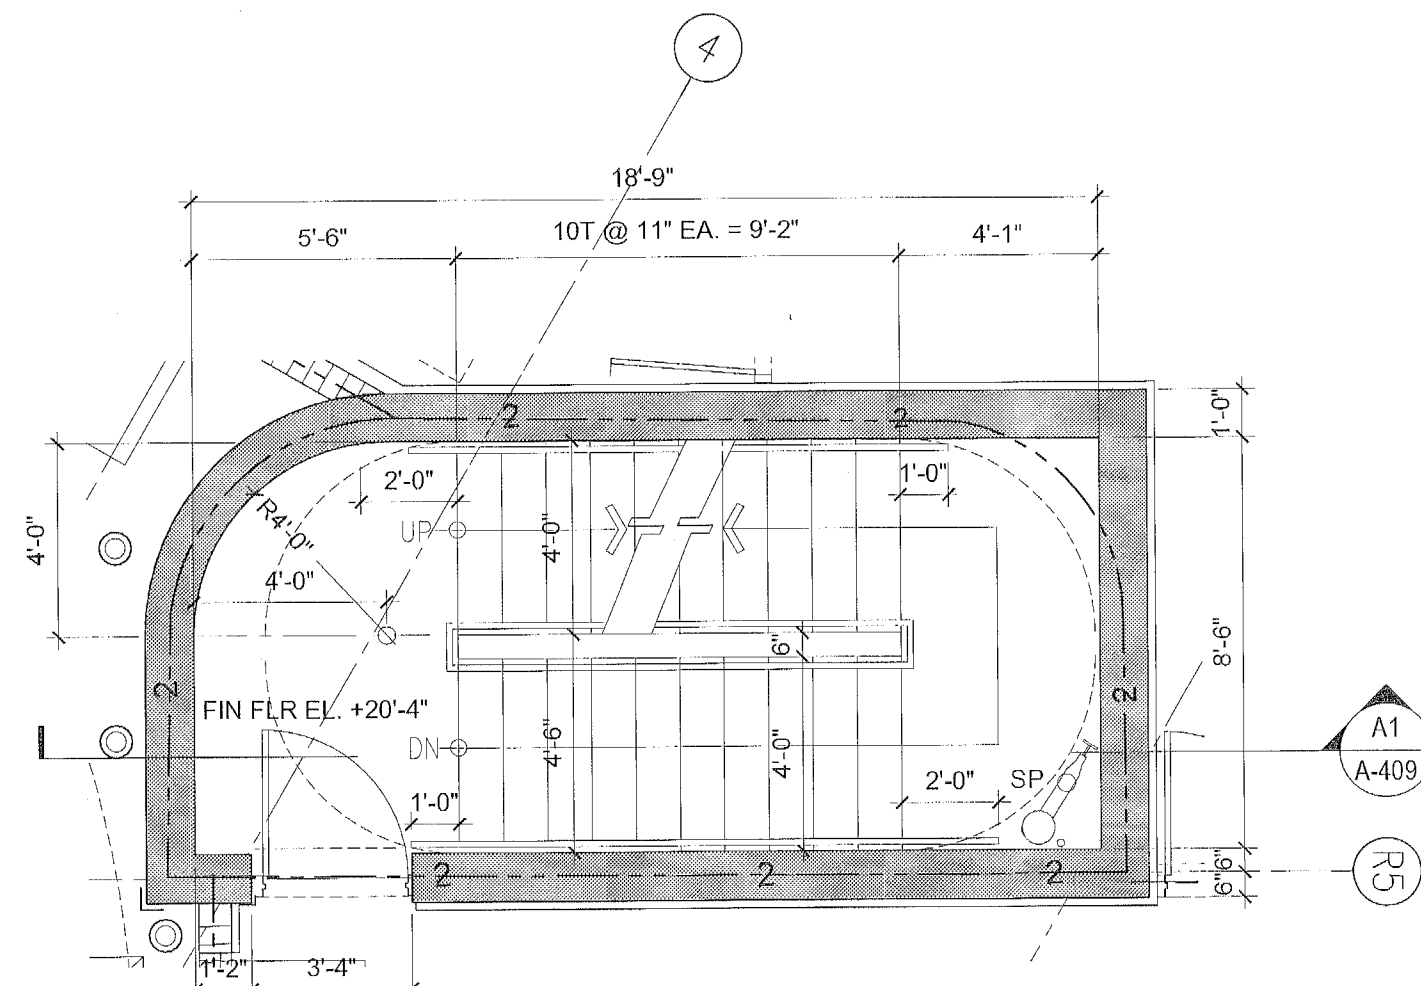


A3 STAIR #1 PLAN - 2ND FLOOR

SCALE: 1/4" = 1'-0"

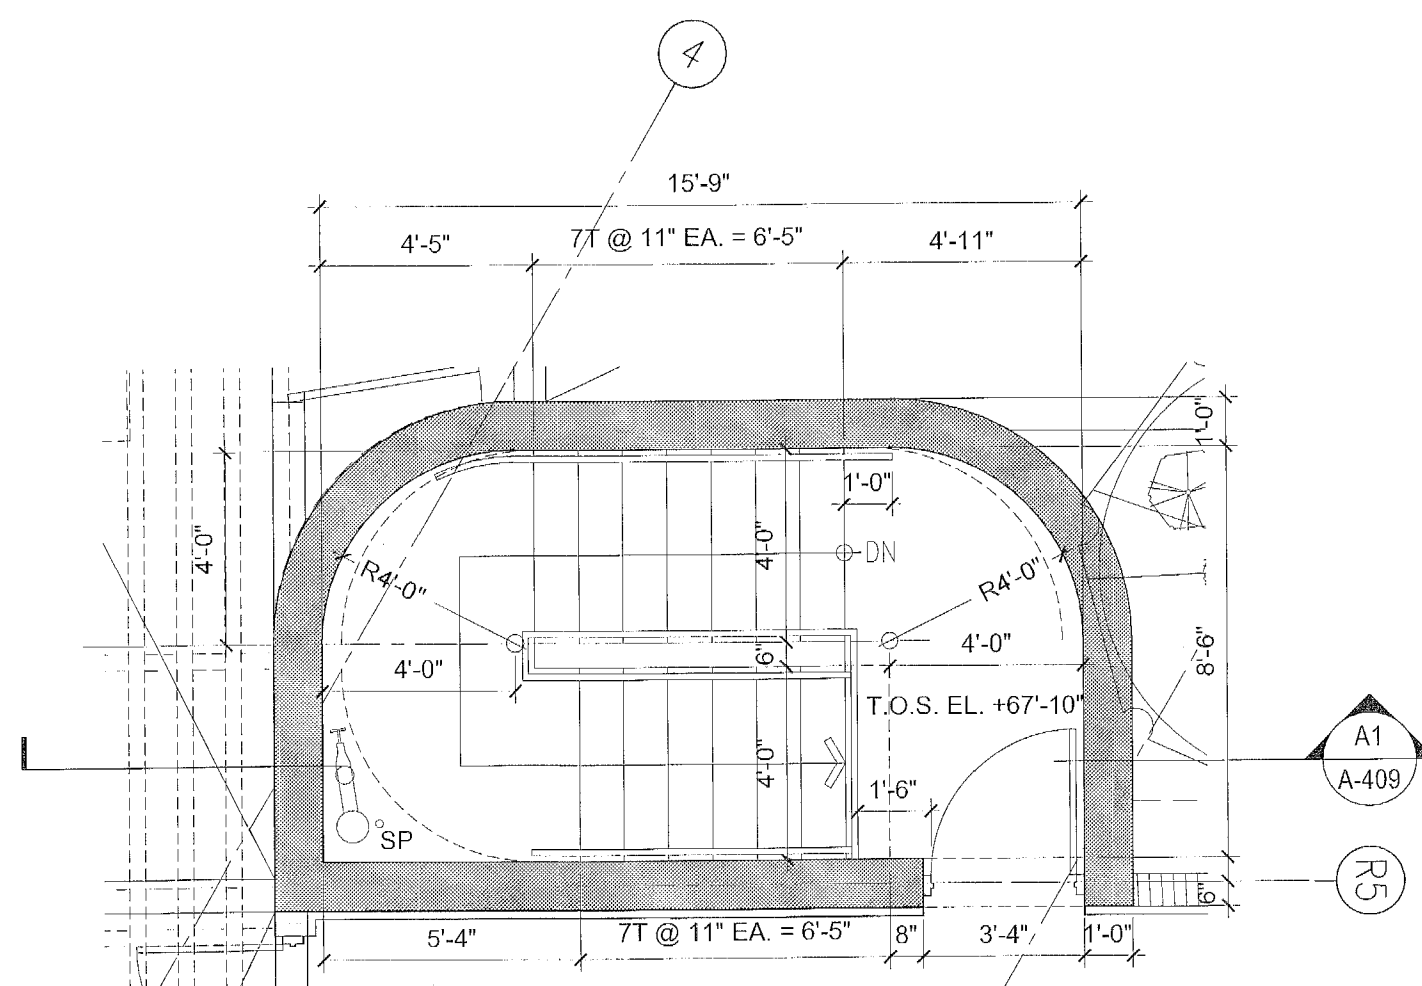


A5 STAIR #1 PLAN - 6TH FLOOR / ROOF

SCALE: 1/4" = 1'-0"

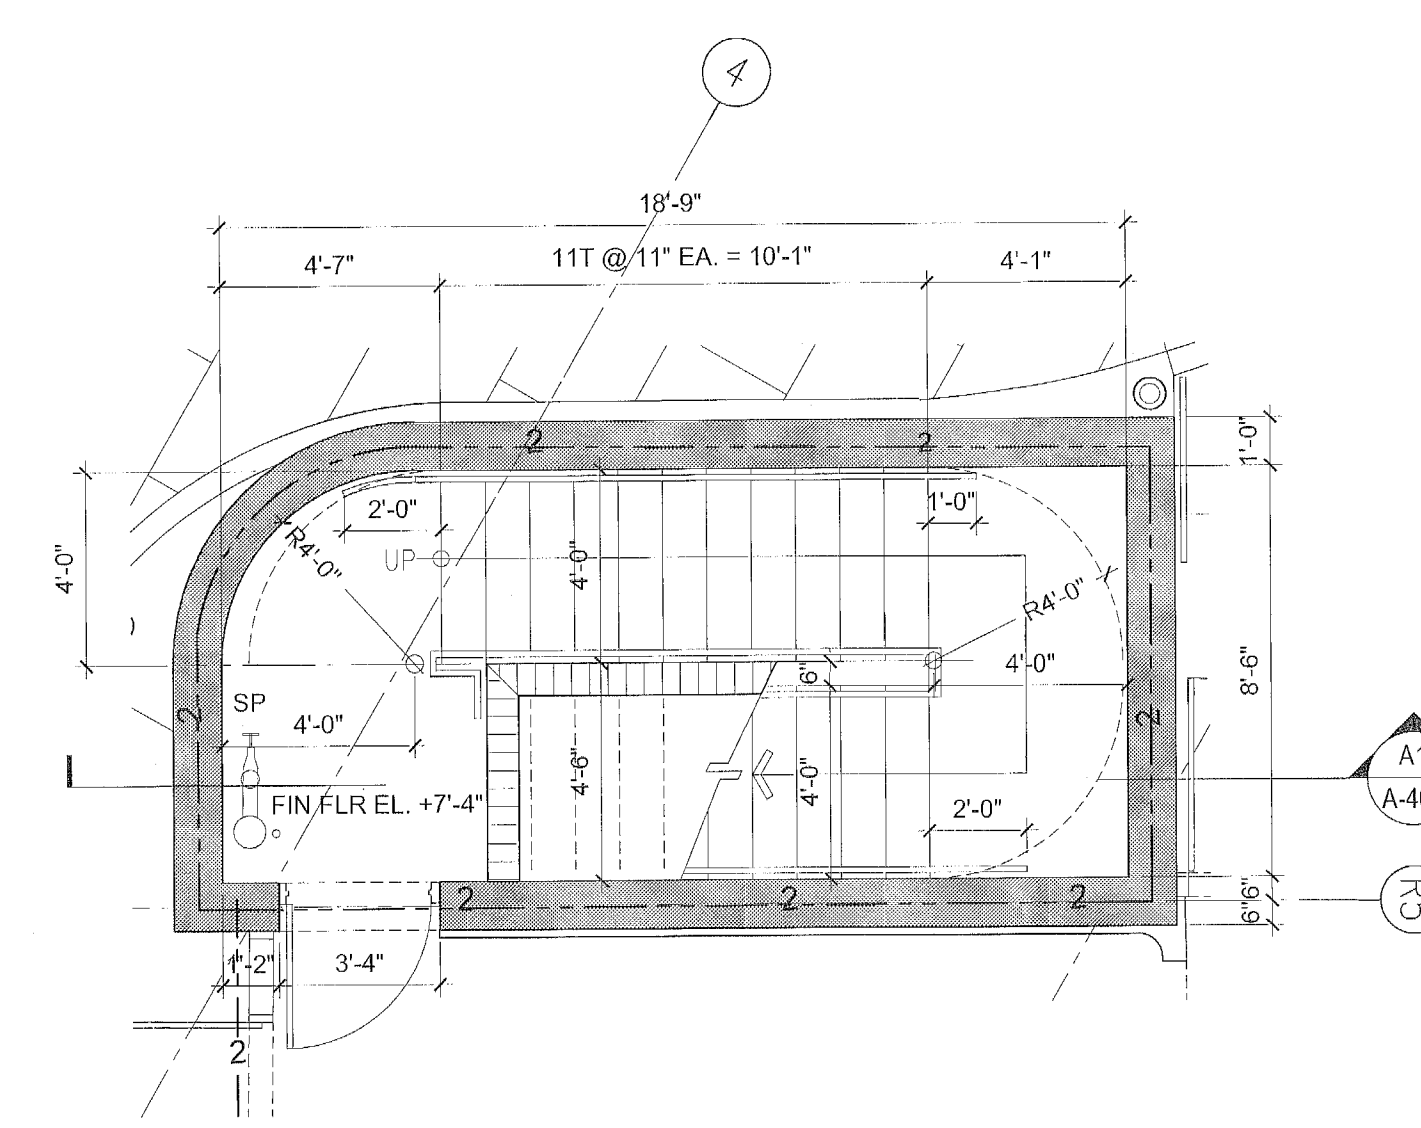

A2 STAIR #1 PLAN - 1ST FLOOR

SCALE: 1/4" = 1'-0"

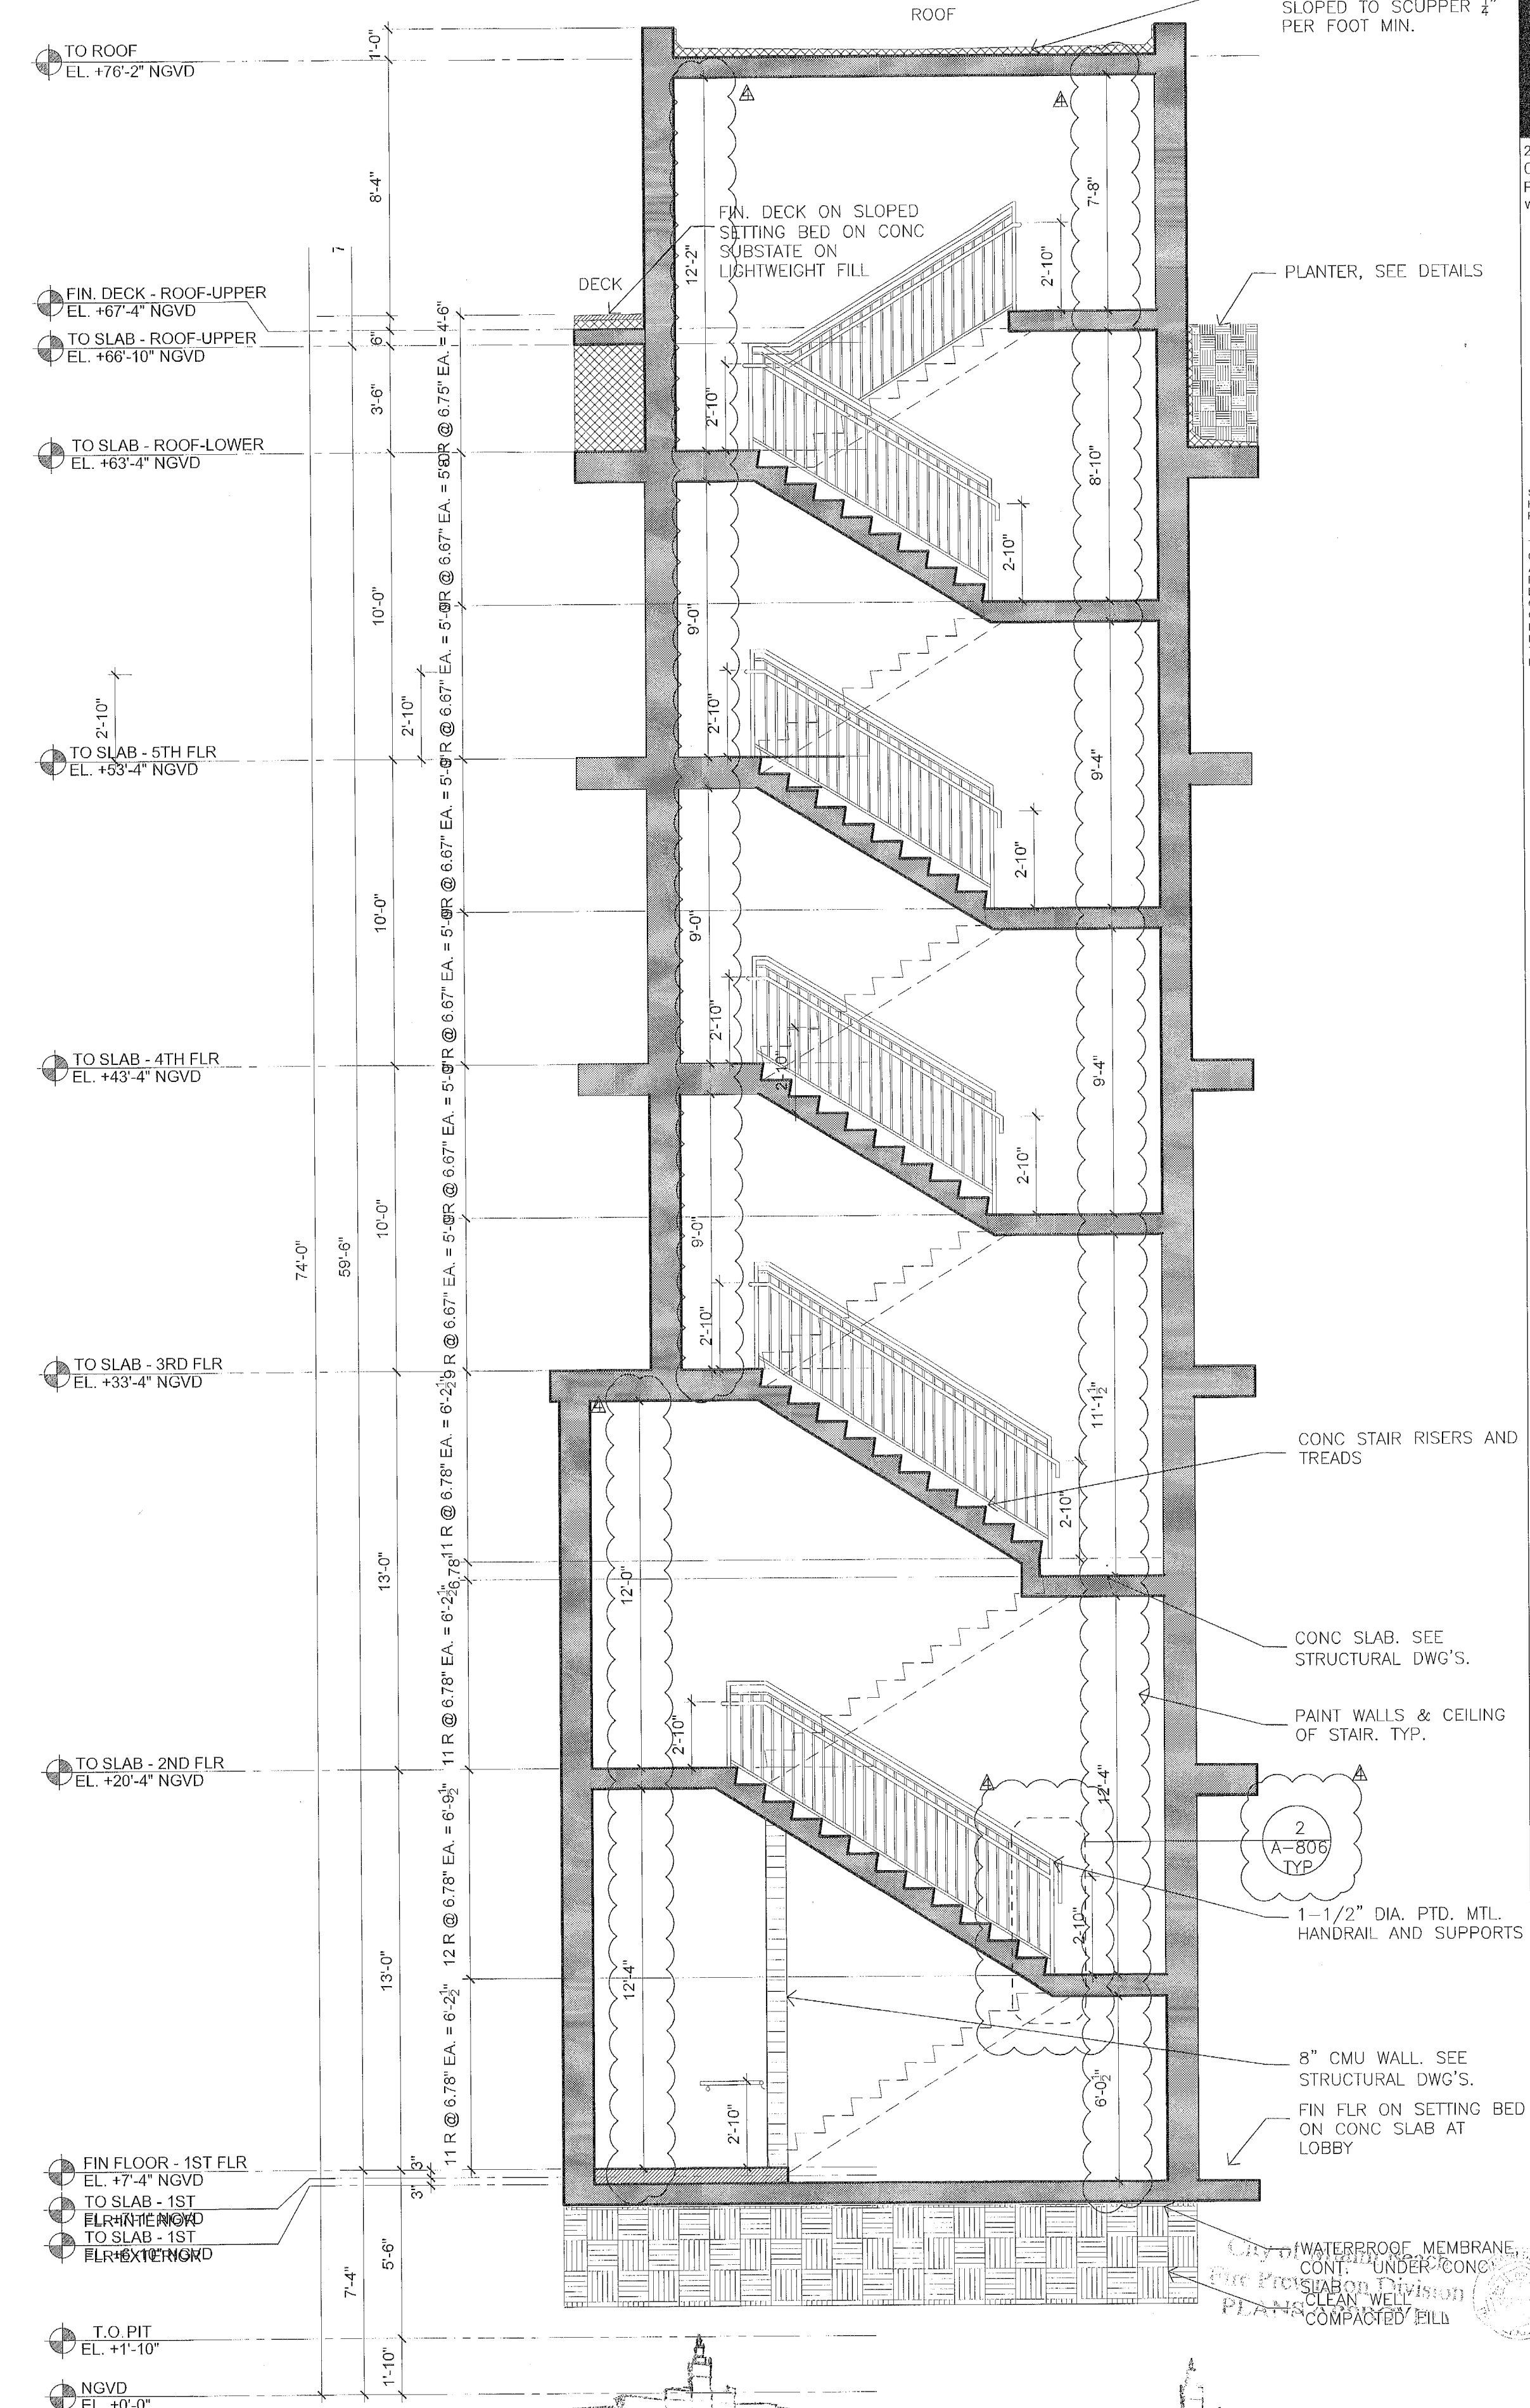

A1 STAIR #1 CROSS SECTION

SCALE: 1/4" = 1'-0"

PRIVATE PROVIDER SERVICES, LLC
Construction Plans Review, Inspections & Consulting
REVIEWED FOR CODE COMPLIANCE

REVIEWER	DATE
WMB	11/22/17

PRIVATE PROVIDER SERVICES, LLC
Construction Plans Review, Inspections & Consulting
REVIEWED FOR CODE COMPLIANCE

REVIEWER	DATE
WMB	11/22/17

Adelita
11.22.17

STATE OF FLORIDA
ALJO MILIAN ARCHITECT
REGISTRATION #AR0004953


THESE DESIGNS AND DRAWINGS ARE THE
UNREPRODUCED PROPERTY OF PERMY
ARCHITECTURE INTERIOR DESIGN AND
ANNING, INC. AND MAY NOT BE REPRODUCED
EXCEPT WITH SPECIFICATION WRITTEN
CONSENT OF THE ARCHITECT. THE
CONTRACTOR MUST CHECK AND VERIFY ALL
DIMENSIONS OF THE JOB AND BE RESPONSIBLE
FOR SAME, REPORTING ANY DISCREPANCIES
TO THE ARCHITECT BEFORE COMMENCING WORK.
DRAWINGS ARE NOT TO BE SCALED

KIMPTON HOTEL
PALOMAR
SOUTH BEACH
1750 Alton Ford, Miami Beach, FL 33139
FINVARE GROUP

[illegible]


PROJECT NO.
1613
DATE:
02.28.17
SHEET INDEX:
SCALE:
As Noted
SHEET NO.

A-410

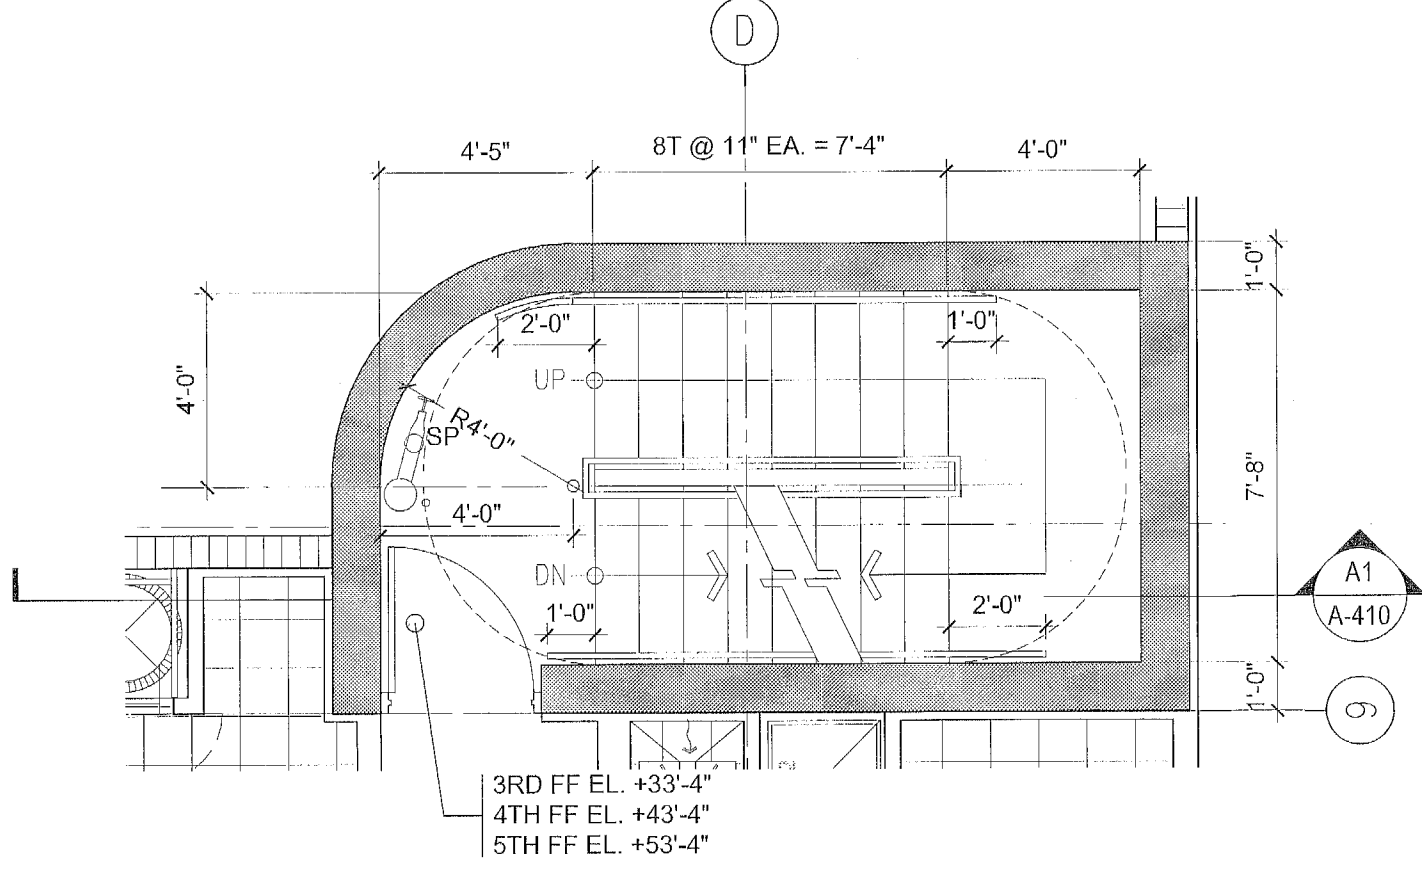


A4 STAIR #2 PLAN - 3-5TH FLOOR

SCALE: 1/4" = 1'-0"

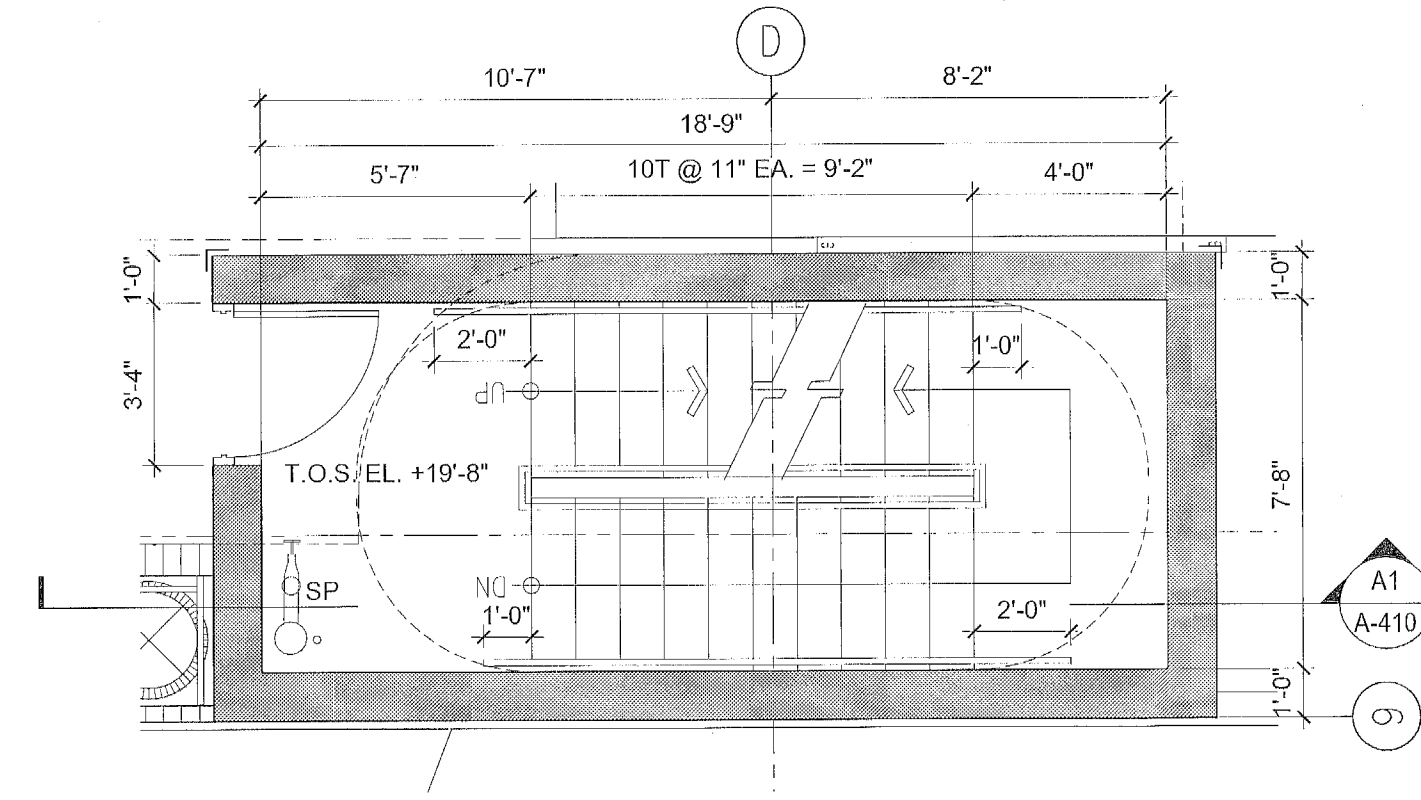


A3 STAIR #2 PLAN - 2ND FLOOR

SCALE: 1/4" = 1'-0"

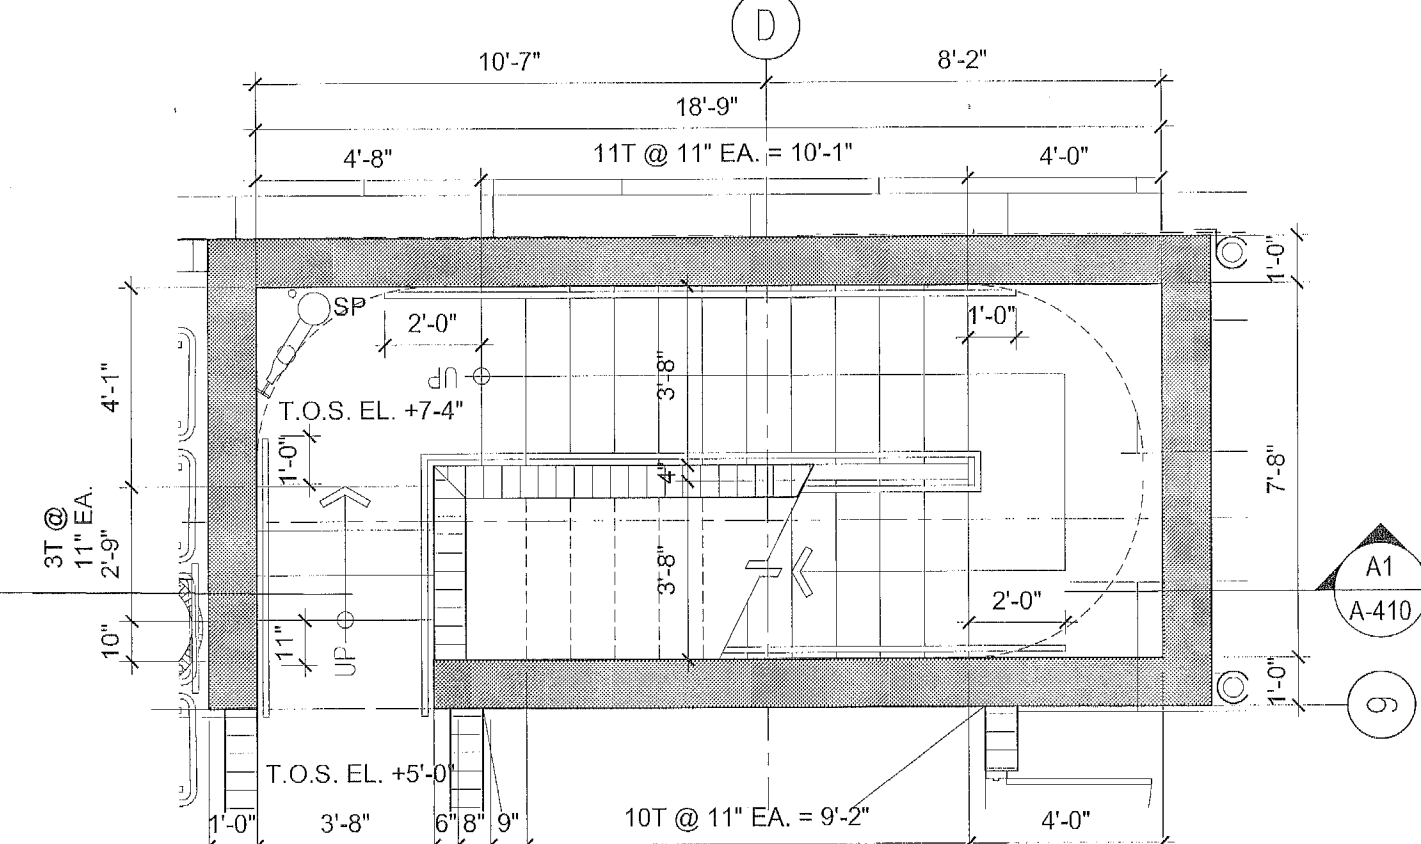


A2 STAIR #2 PLAN - 1ST FLOOR

SCALE: 1/4" = 1'-0"

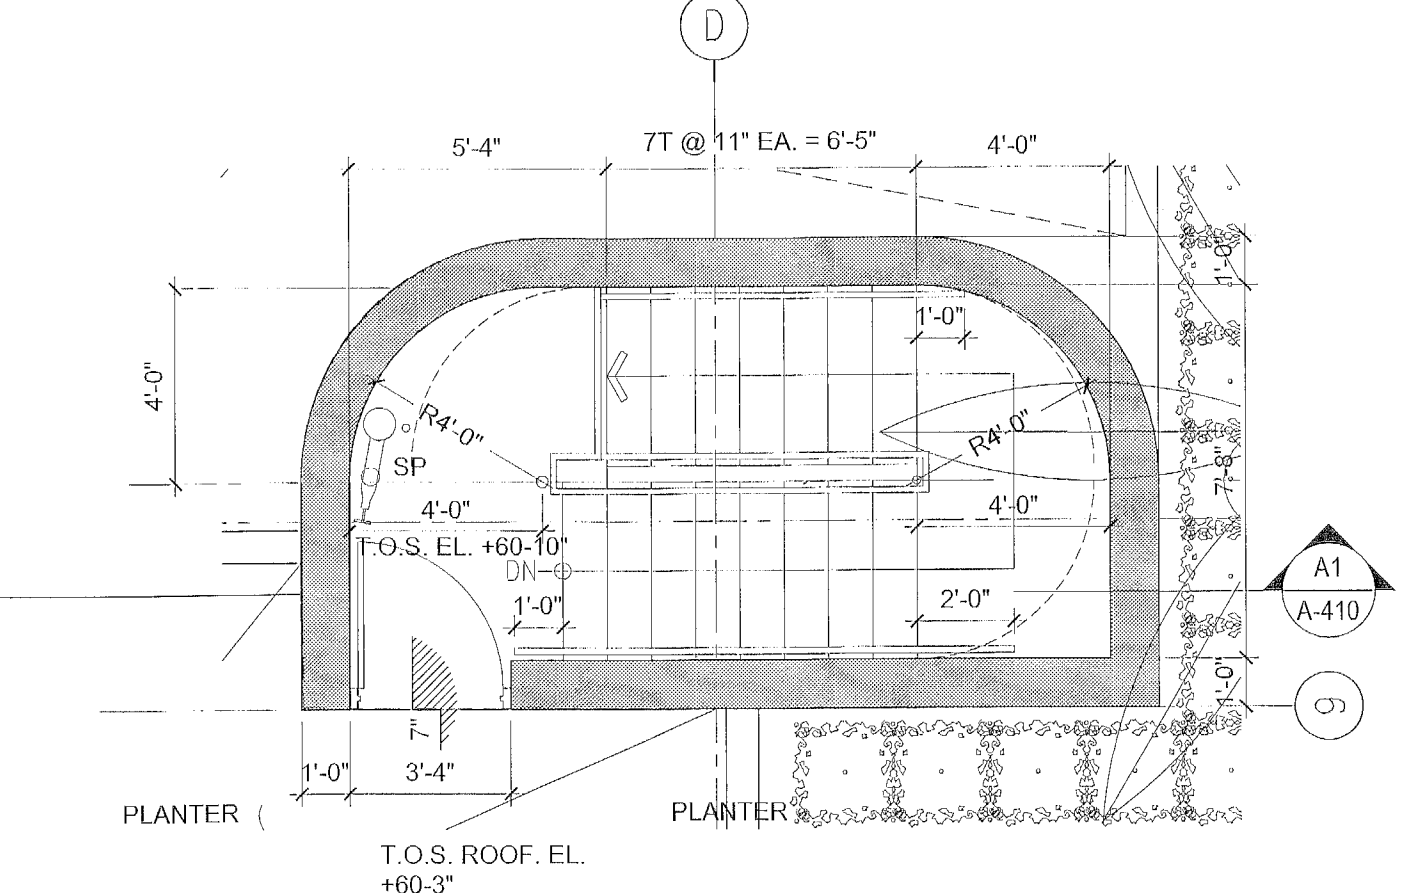


AE STAIR #2 PLAN 6TH FLOOR / ROOF


SCALE: 1/4" = 1'-0"

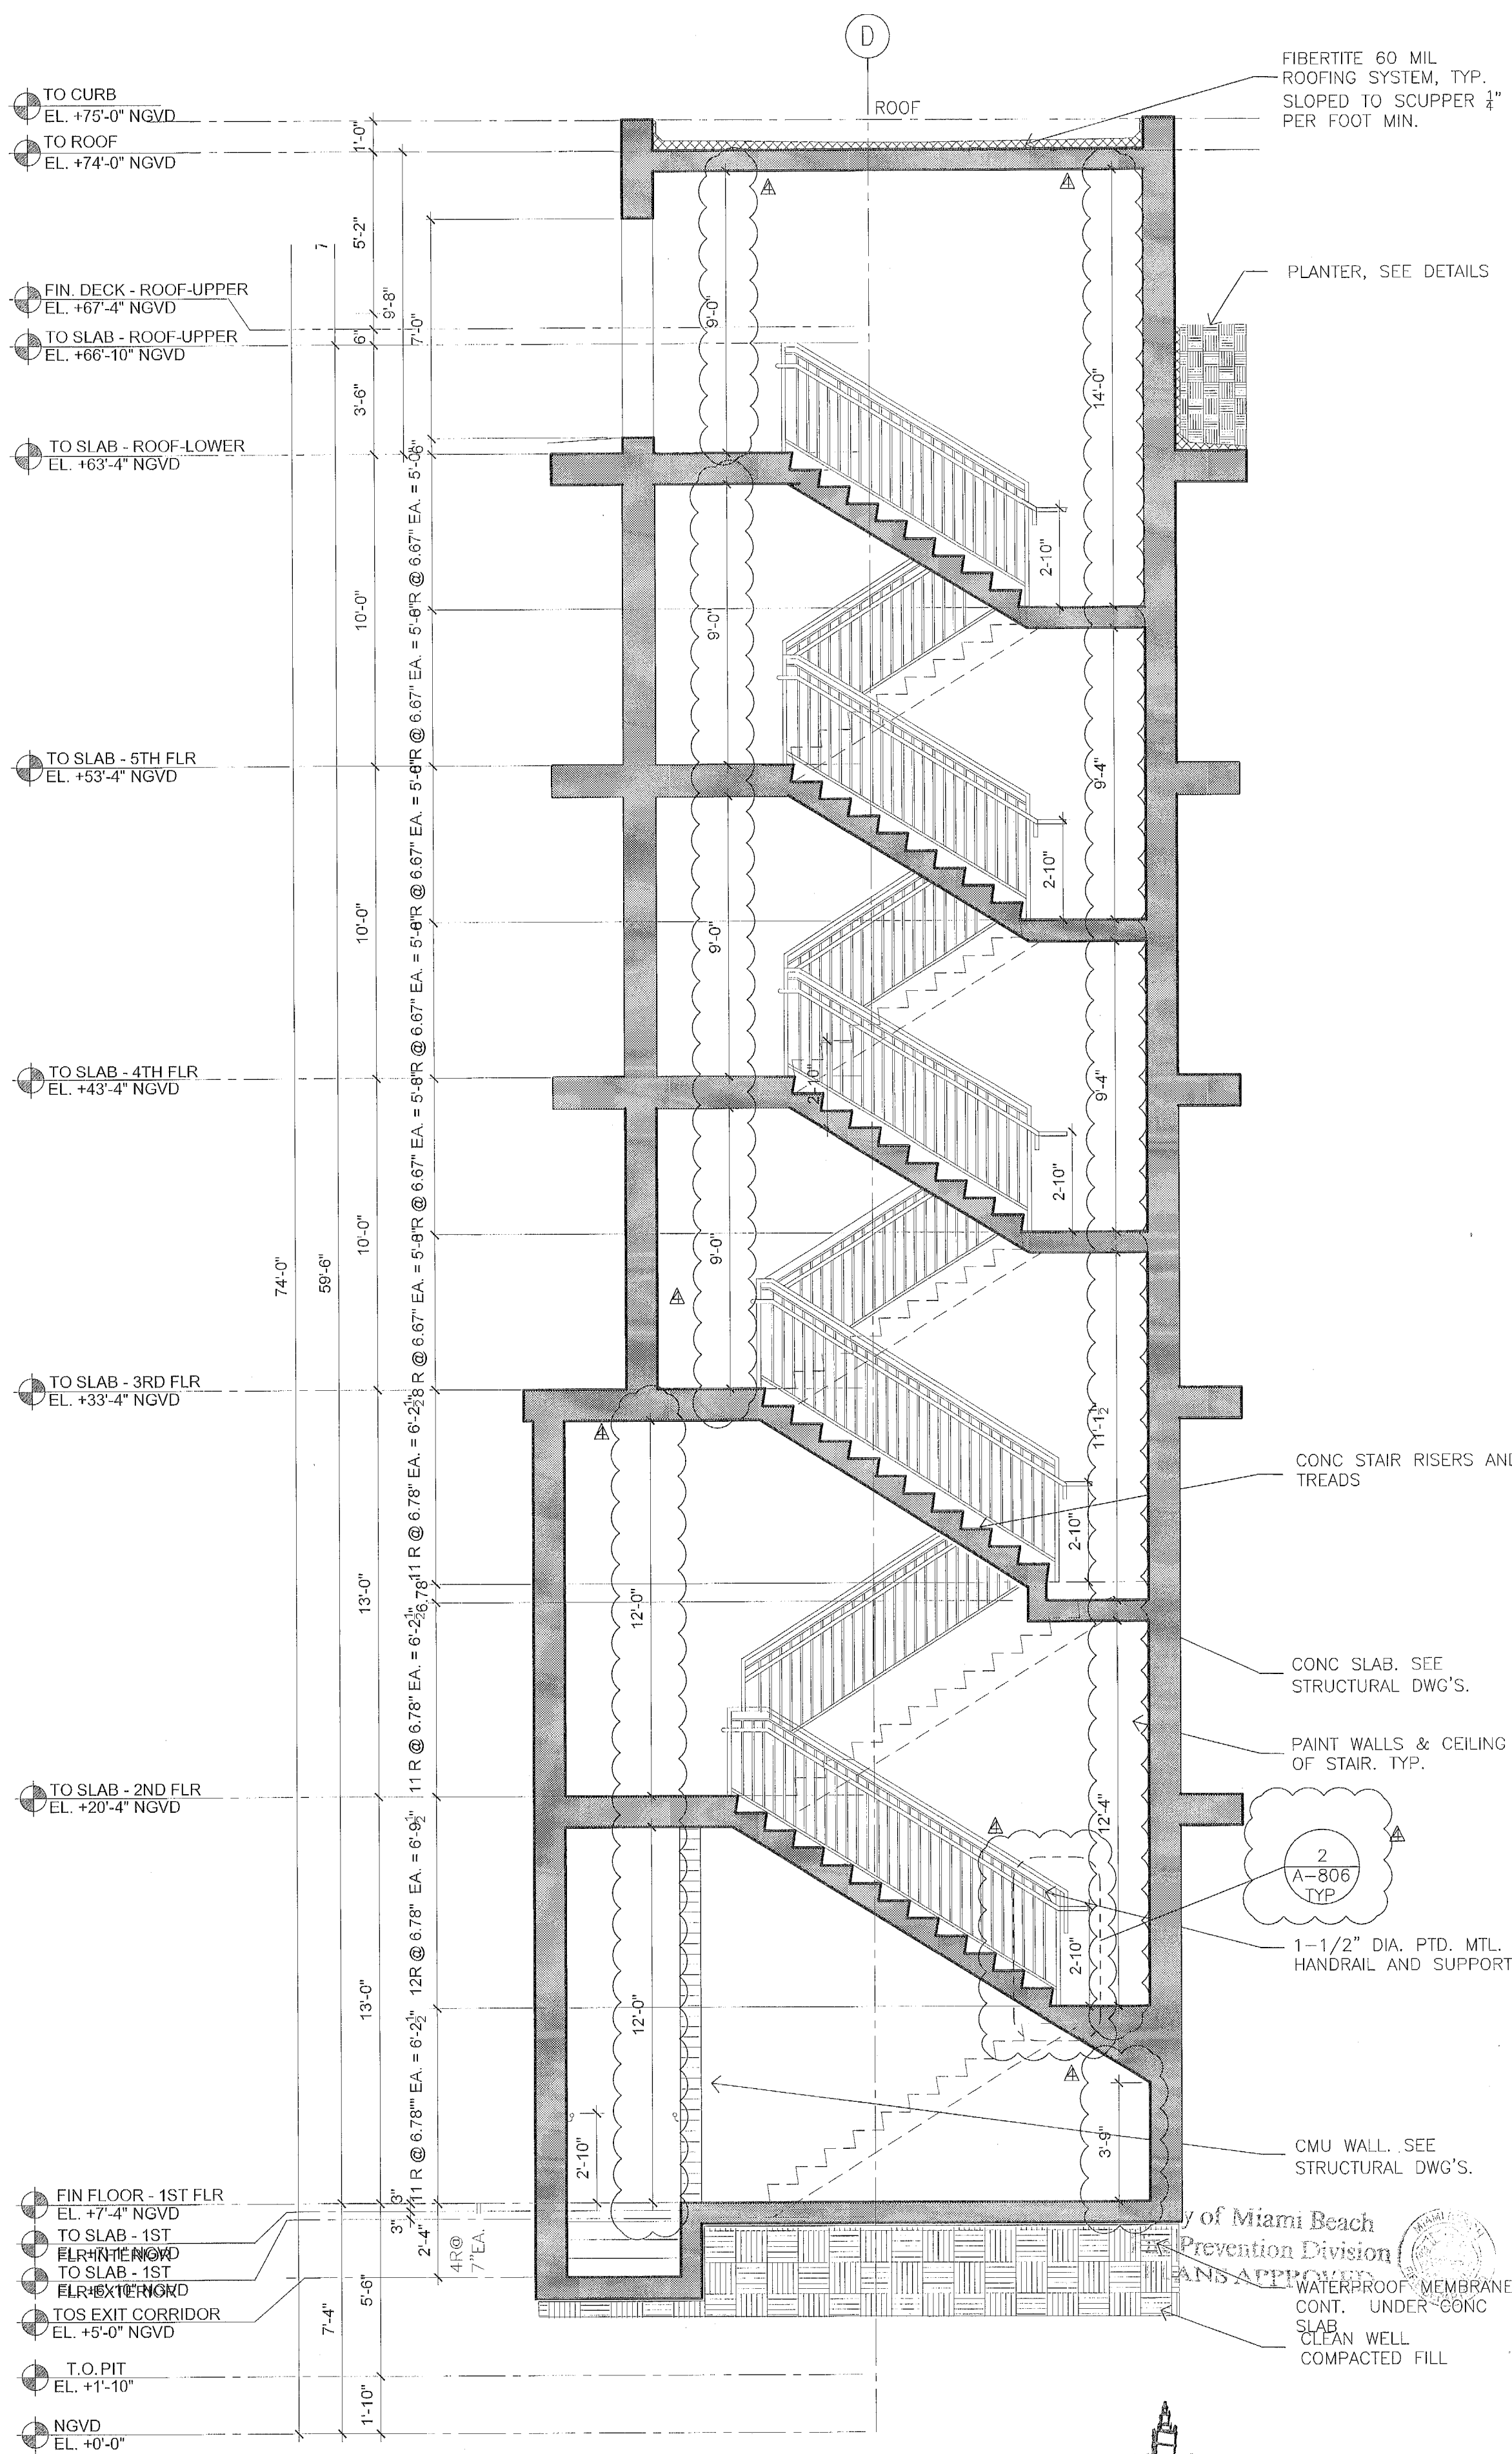

A1 STAIR #2 CROSS SECTION

SCALE: 1/4" = 1'-0"

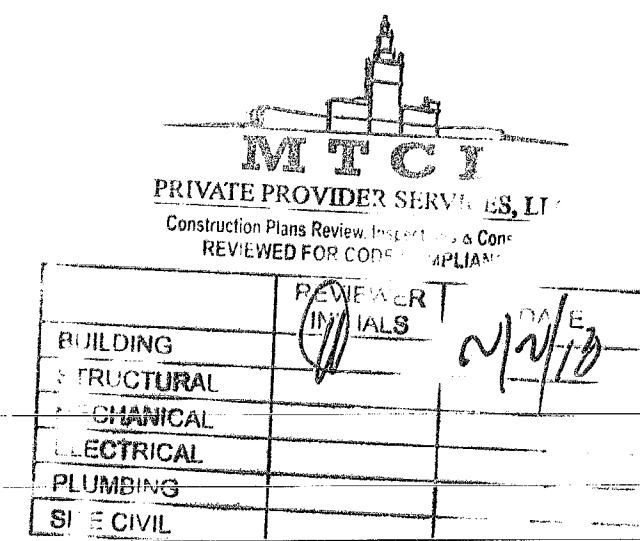


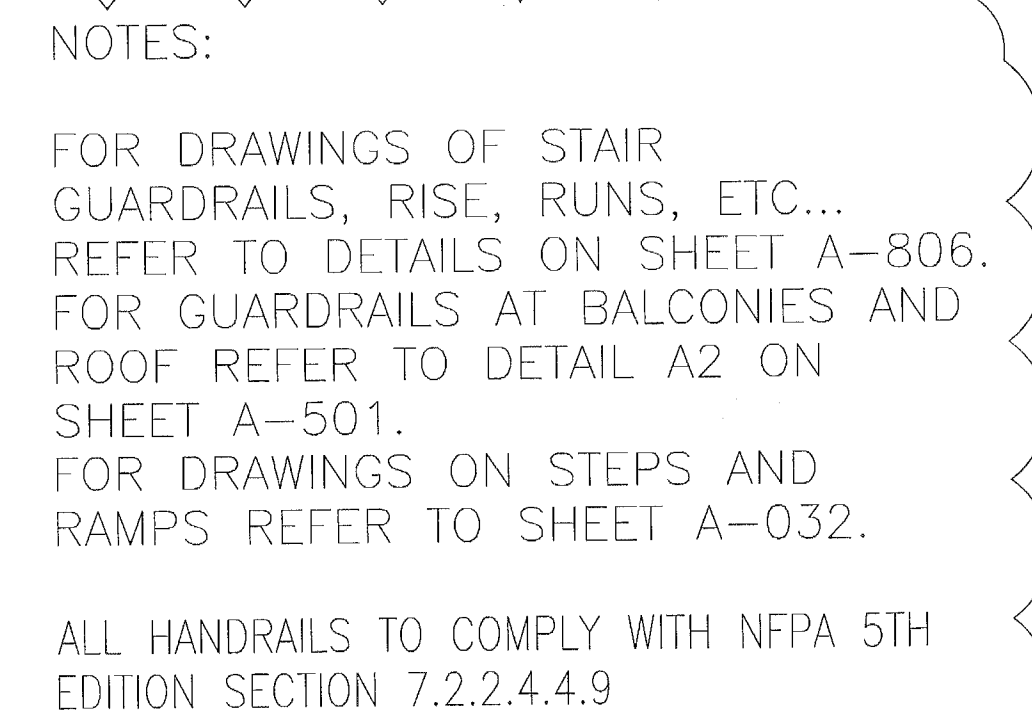


Helio Muler
1.6.78

THESE DESIGNS AND DRAWINGS ARE THE
COPYRIGHTED PROPERTY OF PERMY
ARCHITECTURE INTERIOR DESIGN AND
PLANNING, INC. AND MAY NOT BE REPRODUCED
EXCEPT WITH SPECIFICATION WRITTEN
CONSENT OF THE ARCHITECT. THE
CONTRACTOR MUST CHECK AND VERIFY ALL
DIMENSIONS OF THE JOB AND BE RESPONSIBLE
FOR SAME, REPORTING ANY DISCREPANCIES TO
THE ARCHITECT BEFORE COMMENCING WORK.
DRAWINGS ARE NOT TO BE SCALED



SCALE: 1/4" = 1'-0"

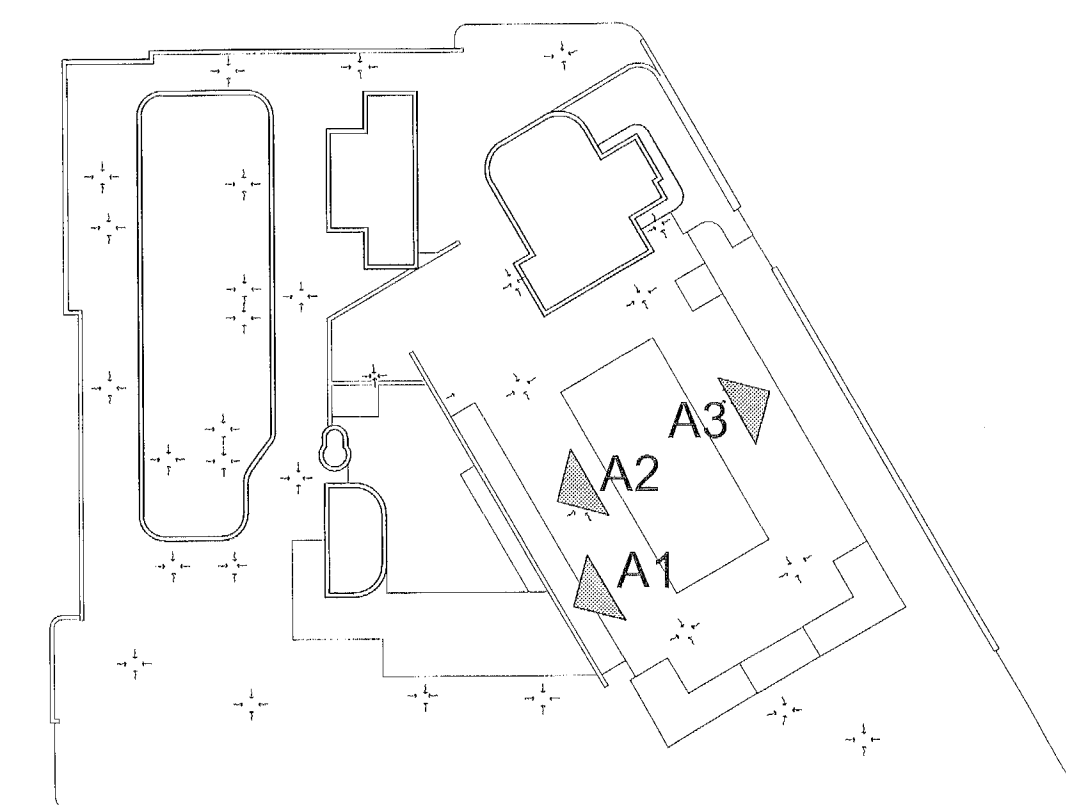

KEY PLAN
N.T.S.

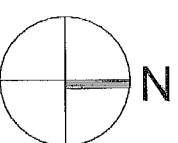

SCALE: 1/4" = 1'-0"

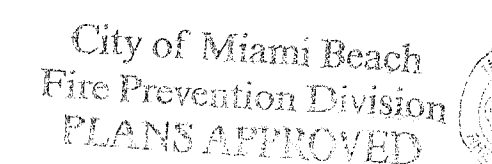 

	REVIEWER INITIALS	DATE
BUILDING	(M)	4/27/13
STRUCTURAL		
MECHANICAL		
ELECTRICAL		
PLUMBING		
SOIL/CIVIL		

SCALE: 1/4" = 1'-0"

[illegible]

PROJECT NO. 1613

DATE: 02.28.17

SHEET INDEX:

SCALE: As Noted

SHEET NO.

A-411