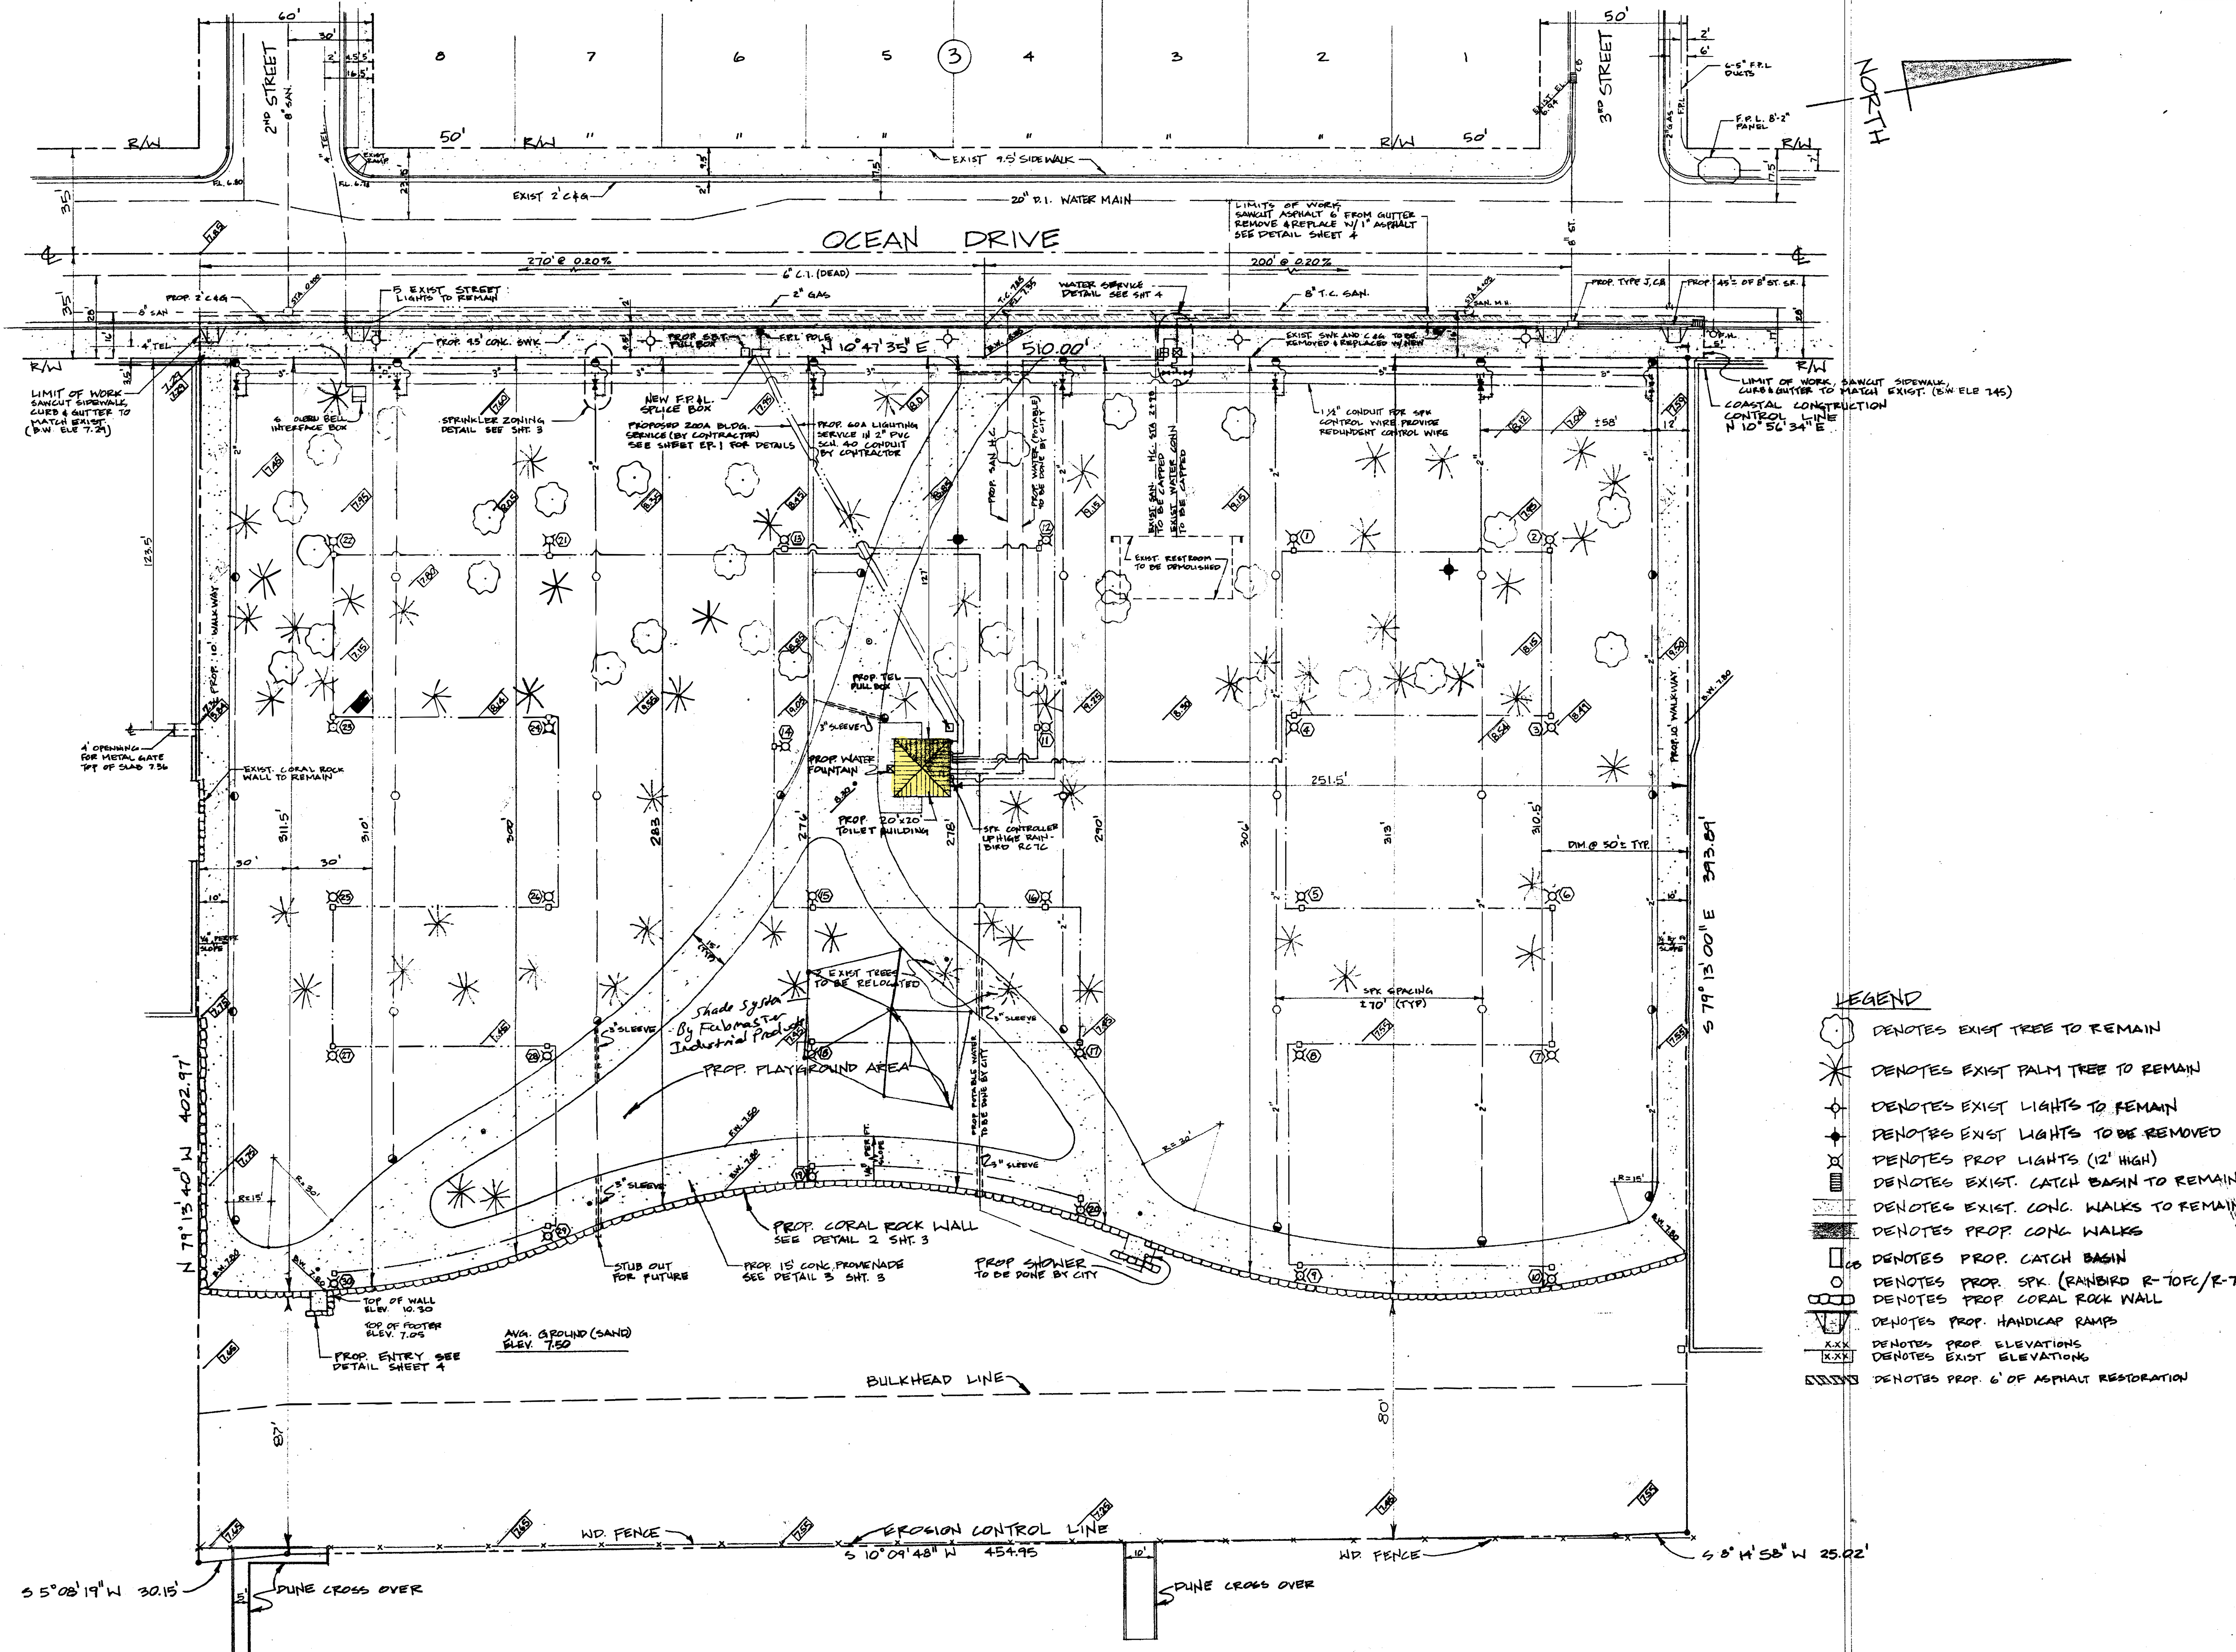

48 HOURS BEFORE DIGGING
CALL TOLL FREE
1-800-432-4770
U.N.C.L.E. UNDERGROUND UTILITIES NOTIFICATION CENTER

NOTES
1. ELEVATIONS REFER TO MEAN SEA LEVEL NATIONAL 1929 DATUM

48 HOURS PRIOR TO EXCAVATING CONTRACTOR SHALL CALL FOR LOCATION OF UNDERGROUND UTILITIES
SUNSHINE ONE-CALL 1-800-432-4770
CITY OF MIAMI BEACH 305-673-7080

Phone 305-673-7080

THIS PLAN REVIEW CONSTITUTES APPROVAL FOR OBTAINING BUILDING PERMITS ONLY.

All construction and/or use of equipment in the right-of-way and/or easements, requires a separate Public Works Department permit prior to start of construction.

Permit Requirements: Proof of existing sidewalk/swale area conditions (pictures) and/or posting of sidewalk-roadway bonds (Public Works inspection of the right-of-way will be required prior to final sign-off on the C.C./C.O., or the release of bonds.)

EXC 07-25-2007

C 7/26/07

T Armstrong 7/13/07

EXC 07 25 2007 07/25/07 7/25/07

CITY OF MIAMI BEACH
FLORIDA

PUBLIC SERVICES DEPARTMENT — ENGINEERING DIVISION

DESIGNER: R. GATTI	CITY MANAGER: ROGER CARLTON	TITLE: RENOVATE AND UPGRADE OCEAN BEACH PARK OCEAN DRIVE BTW. 2 & 3 STS. (PROP. PLAN)	WORK ORDER:
DRAFTSMAN: L. FRANCIS	PUBLIC SERVICES DIRECTOR: R. GATTI		FIELD BOOK 1125-28
CHECKER: D. RODRIGUEZ	CITY ENGINEER: R. GATTI		DRAWING NUMBER PK 91B
SCALE: 1"=30.0'	DATE: MAY 31 1991		SHEET 2 OF 4